4626078220

# IREDELL COUNTY HEALTH DEPARTMENT

STATESVILLE 704-878-5305 MOORESVILLE 704-664-5281

## IMPROVEMENT PERMIT / CERTIFICATE OF COMPLETION / OPERATION PERMIT / EXISTING SYSTEM INSPECTION

PROPERTY DESCRIPTION NO. 16302 DATE Oct. 19, '93 TAX MAP NO. 2F3A 173 Watershed: ☑ Yes ☐ No LN.

OWNER OR CONTRACTOR Robert E. Weisenberger Jr. PHONE: Business _____ Home _____

ADDRESS _____

LOCATION 1106 TR 1115, TL 2nd Kemp Rd, back to right 2nd lot on left

SUBDIVISION Crescent Lake Resort Block / SECTION 8 LOT 173 LOT AREA ~3/4 Ac (added) SITE CLASS. B DESIGN FLOW 360gpd L.T.A.R. n.e. 4

Septic Tank: 1000 Gallons; STB 794 Dellinger Date 8-4-93

Pump Tank: _____ Gallons; PT _____ Date _____

Pump Make: _____ Model _____ Serial No. _____

Nitrification Field: No Fields 2 Square Feet 474+Ex. Linear Feet 158+Ex.

No Lines 24+Ex. Trench Width 36" Max Trench Bottom Depth ~30" Gravel Depth 12"

☐ New System ☑ Repair System Type: I (II) III, IV, V, VI

System Description: grav. conventional

Repair System Description: _____

Maintenance Agreement Required: ☐ Yes ☑ No

☑ House/Mod. Home No. Bedrooms 3

☐ Mobile Home No. Bathrooms 2-3

☐ Business No. Employees _____

☐ Other _____

☐ Slab ☐ Crawl Space ☐ Basement w/plumbing ☐ Basement wo/plumbing


Water Supply: ☑ Individual ☐ Community ☐ Public

Comments:

Comments: New tank set. New lines set to feed at BR VALVE.

INITIAL SITE SKETCH

AS BUILT SKETCH

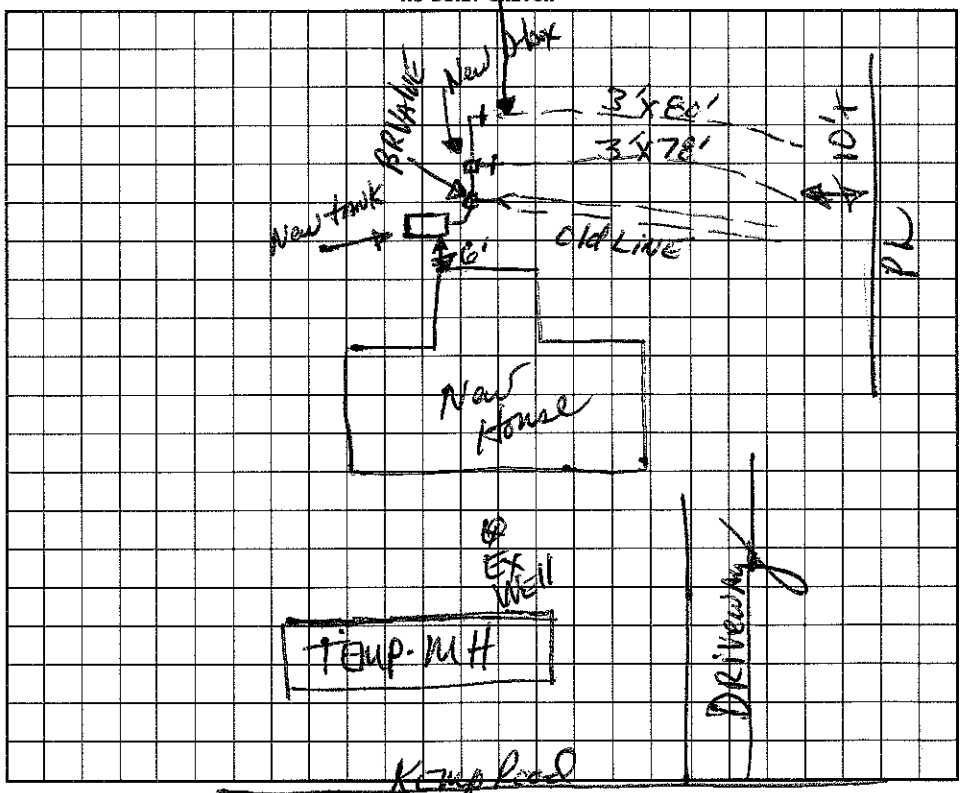


I understand that this permit can be suspended or revoked if any false information is supplied toward securing the permit/any unauthorized changes are made to the site/any unauthorized changes are made in the installation of the system. Improvement Permit is valid for 60 months from date of issuance.

Signed: _____

Improvement Permit by: _____ date _____

Existing System Inspection by: _____ date _____

Installed by: MacLeod Construction

Certificate of Completion by: [signature], RS date 10/19/93

Operation Permit by: _____ date _____

HEALTH DEPT. COPY: WHITE INSPECTION COPY (FINAL): GREEN OWNER COPY (FINAL): YELLOW INSPECTION COPY (INITIAL): PINK OWNER COPY (INITIAL): GOLD