IREDELL COUNTY HEALTH DEPARTMENT

STATESVILLE 704-878-5305 MOORESVILLE 704-664-5281

IMPROVEMENT PERMIT / AUTHORIZATION TO CONSTRUCT / OPERATION PERMIT / EXISTING SYSTEM INSPECTION

PERMIT# 114940 20 PIN# 4626 08 2299 DATE 2/15/06

OWNER OR APPLICANT David Dauley / Quest Homes PHONE: Business 704-400-4358 Home

ADDRESS PO Box 3562 Mooresville, NC 28117

LOCATION 1100 TR MS Kerr 3.5 miles TR 2 ND Lakeview Shores LP on L just past Renwick Ln. 700 Lakeview Shores LP

SUBDIVISION CL+T BLOCK / SECTION 8 LOT 627 LOT AREA .8 SITE CLASS. PS DESIGN FLOW 480 L.T.A.R. .3

Septic Tank: 1000 Gallons: STB 1012 Date 3/5/06 ~~4/5~~

Pump Tank: 1000 Gallons: PT 17 Date 7/20/06 ~~4/5~~

Pump Make: Gaulds Model WE0311M Serial No.

Nitrification Field: No Fields 1 Square Feet 534/801 Linear Feet 267

No Lines 4 @ 67 Trench Width 2 Max Trench Bottom Depth 3' Gravel Depth NA ☐ Gravity ☒ Pressure

☒ New System ☐ Repair ☐ Expansion System Type: I II III IV V VI

System Description: Pressed - 14" PPBRS

Repair System Description: < 83 flutted

Maintenance Agreement Required: ☒ Yes ☐ No

☒ House/Mod. Home ☐ Mobile Home ☐ Business ☐ Other


No. Bedrooms 4 No. Persons 4 No. Employees

Water Supply: ☒ Individual ☐ Public ☐ Community

☐ Slab ☐ Crawl Space ☒ Basement w/plumbing ☐ Basement wo/plumbing

Comments:/Conditions:

INITIAL SITE SKETCH

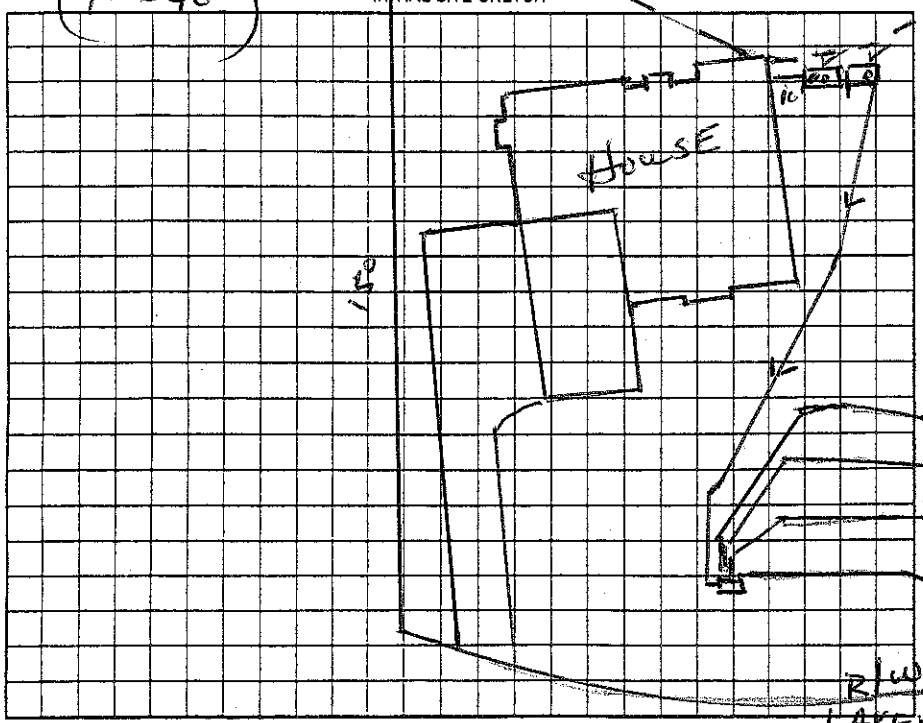


Comments:/Conditions: 9/22 - one panel short on line

9-27-06 panels added, to make lines 67'

all lines checked - top line

AS BUILT SKETCH

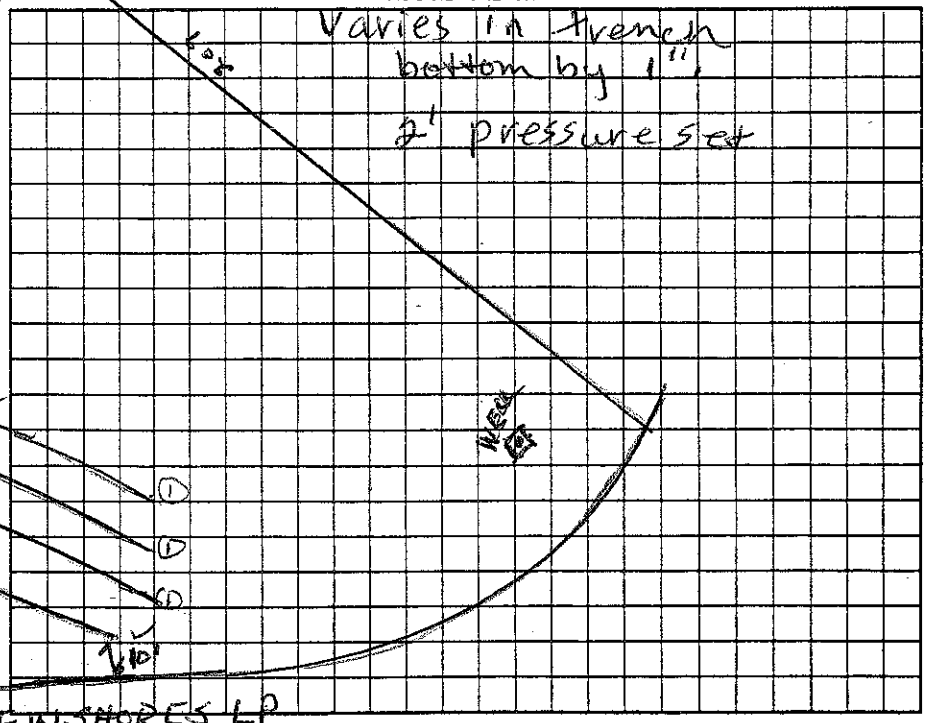

Permit can be suspended or revoked if any false information is supplied toward securing the permit/any unauthorized changes are made to the site/any unauthorized changes are made in the installation of the system. Improvement Permit with plat valid without expiration ☐ Improvement Permit with site plan valid for sixty months ☐ Authorization to Construct is valid for a period equal to that of Improvement Permit – not to exceed sixty months.

Signed: [signature] date 2-15-06

Improvement Permit by: Wesley Sparks RS date 2/15/06

Authorization to Construct by: Wesley Sparks RS date 2/15/06

Installed by: Craig Thompson

Operation Permit by: Jerry Melville date 9-27-06

Existing System Inspection by: date

HEALTH DEPT. COPY: WHITE OWNER COPY (FINAL): YELLOW OWNER COPY (INITIAL): PINK