1729950 1462608398 7 3 lots

IREDELL COUNTY HEALTH DEPARTMENT - *ENVIRONMENTAL HEALTH* ☐ STATESVILLE OFFICE 704-878-5305 ☐ MOORESVILLE OFFICE 704-664-5281

IMPROVEMENT PERMIT / AUTHORIZATION TO CONSTRUCT / OPERATION PERMIT / EXISTING SYSTEM INSPECTION

PERMIT # 13276 PIN # 4626071828.480 DATE 5-15-2012

OWNER Tom Palmer Homes APPLICANT: Same PHONE: Home/Cell # 704 780 1448 Business # 980 241 9693

SITE ADDRESS 130 E. Cold Hollow Farms OWNER / APPLICANT ADDRESS P.O. Box 2387 Davidson NC 28036

SITE DIRECTIONS Brawley School Rd TR McKendree TR Bare Foot Ln TL West Cold Hollow Farms on R to end

SUBDIVISION The Farms BLOCK / SECTION 4 LOT # 480 LOT AREA 1.18 Ac+.181 SFE DESIGN FLOW 480gpd L.T.A.R. .25

Septic Tank min. 1000 Gallons: STB 335 Date 4-30-12 ☒ New System ☐ Repair ☐ Expansion System Type I II III IV V VI

Pump Tank 1500 Gallons: P T Date System Description: Gravity - 25% Reduction OFF SITE

Pump Make Model Serial # Repair System Description: Pump - 50% Reduction

No. Nitrification Fields: 1 No. Lines 6 Linear Feet 480 Maintenance Agreement Required ☒ YES ☐ NO

Trench Width 36" Max. Trench Bottom Depth 36" Gravel Depth N/A ☒ GRAVITY ☐ PRESSURE


☒ Residence No. Bedrooms 4 ☐ Business No. Persons ☐ Other No. Employees ☐ Slab ☒ Crawl Space ☐ Basement w/plumbing ☐ Basement w/o plumbing

Water Supply: ☐ Private ☐ Public ☒ Community

Comments / Conditions: * Note: House plumbing must be Stubbed out high to maintain Gravity Flow to ST. Otherwise a pump will be required.

* Use ST size required by "The Farms" Subdivision Repair OFF site on 501-480A SFE located on Bare Foot Ln. * Installed inspection ports per sketch (Certified Operation required)

INITIAL SITE SKETCH

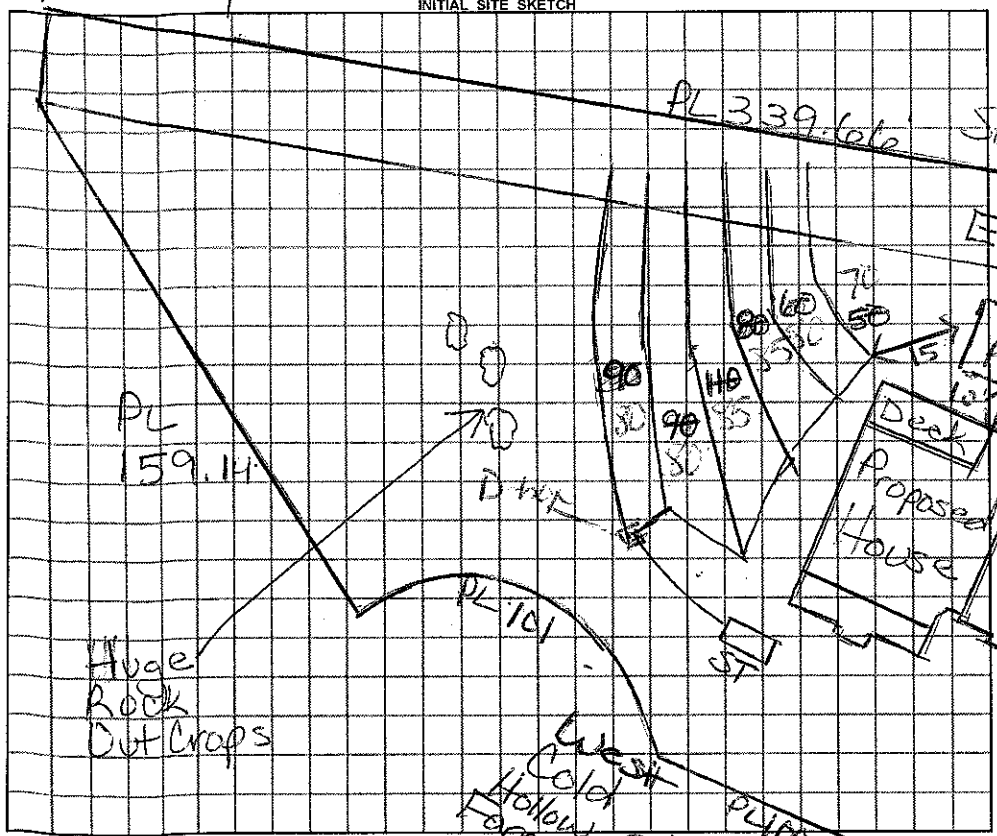

AS BUILT SKETCH

Permit can be suspended or revoked if any false information is supplied toward securing the permit / any unauthorized changes are made to the site / any unauthorized changes are made in the installation of the system.

☐ ***IMPROVEMENT PERMIT*** with plat valid without expiration. ☐ ***IMPROVEMENT PERMIT*** with plat valid without expiration site plan valid 60 mo. ☐ ***AUTHORIZATION TO CONSTRUCT*** valid for period equal to IMPROVEMENT PERMIT–not to exceed 60 mo.

Owner / Applicant Signature Tom Palmer Date Installed by: Kevin Hallman

IMPROVEMENT PERMIT by: REHS Date 5/15/12 OPERATION PERMIT by: REHS Date 11/1/12

AUTHORIZATION TO CONSTRUCT by: REHS Date 5/15/12 Existing System Inspected by: REHS Date

YOU SHOULD CONTACT A LOCATOR SERVICE PRIOR TO ANY EXCAVATION

White Copy – Environmental Health YELLOW COPY (Final) Owner / Applicant PINK COPY (Initial) Owner / Applicant