ICHD–ENVIRONMENTAL HEALTH DIVISION

Statesville Office (704) 878-5305 | Mooresville Office (704) 660-3625 | PERMIT # AP-306347

SEPTIC IMPROVEMENT PERMIT / AUTHORIZATION TO CONSTRUCT / OPERATION PERMIT / EXISTING SYSTEM

PIN # 4626085583

APPLICANT/OWNER: Mike Swatsworth | APPLICANT ADDRESS: 115 West Cold Hollow Farms Dr. Mooresville, NC

SITE ADDRESS: 115 West Cold Hollow Farms Dr. Mooresville, NC | PHONE: 479-418-3512 | ALT. PHONE —

SITE DIRECTIONS: Brawley School → R on McKendree → R on Bare Foot → L on West Cold Hollow Farms → lot on L | SAP CONTROLLED: ☐ YES ☑ NO


SUBDIVISION: The Farms | SECTION: 4 | LOT # 476 | LOT AREA: .912ac | DESIGN FLOW: 480gpd | L.T.A.R.: .25

Septic Tank existing 1000 (gal)	STB 444	Date 6-29-19	☐ New System ☑ Repair ☐ Expansion	System Type: I II (III) IV V VI	☑ Residence	No. Bedrooms 4	Water Supply
Pump Tank (gal)	PT	Date	System Description: 25% reduction		☐ Business	No. Persons 8	☐ Private
Pump Make	Model	Serial #	Repair System Description: LP PPBPS		☐ Other	No. Employees	☐ Public
# Nitrification Fields	# Lines	Linear Ft 20'	Maintenance Agreement Required:	☐ YES ☑ NO	☐ Slab	☑ Crawl Space	☑ Community
Trench Width 36"	Trench Bottom Depth(Low side) 16"	Gravel Depth —	☑ GRAVITY	☐ PRESSURE	☐ Basement w/plumbing	☐ Basement w/o plumbing	


Comments / Conditions: The purpose of this permit is to replace a damaged drain line while constructing pool. 2 chambers were replaced on the 3rd drain line.

*20' was added to the 4th line. 20' disconnected from the last line due to retaining wall cut. Suitable cover was brought in to cover 20' added to 4th line.

INITIAL SITE SKETCH

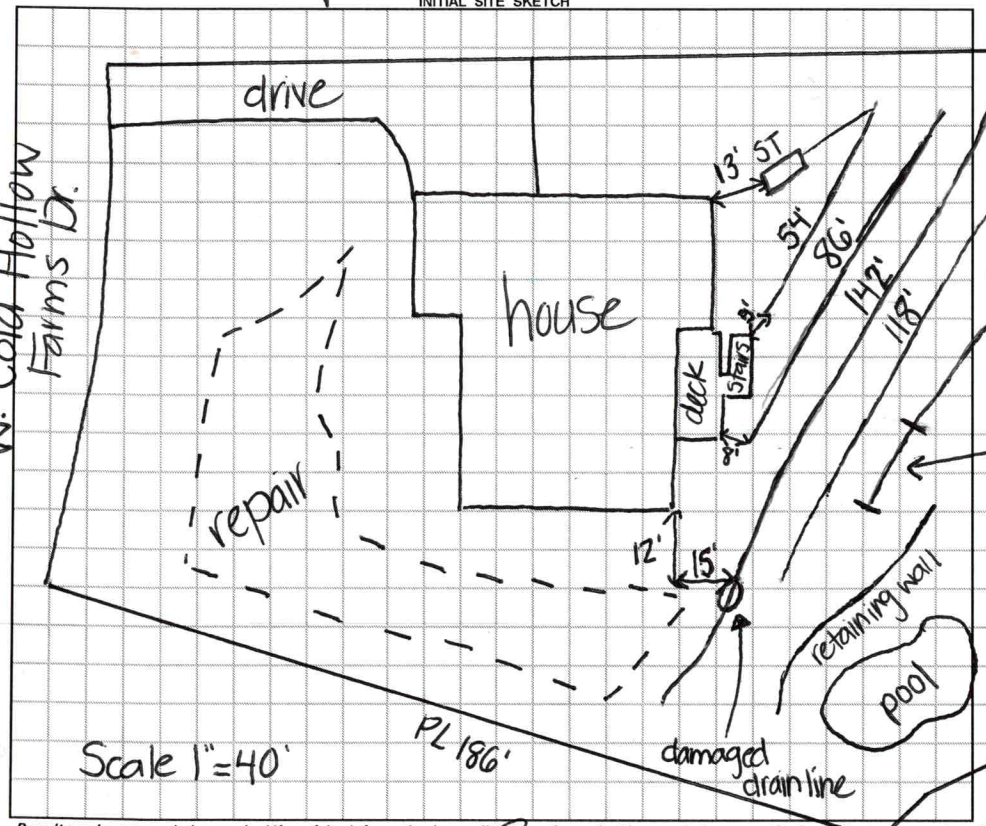

AS BUILT SKETCH

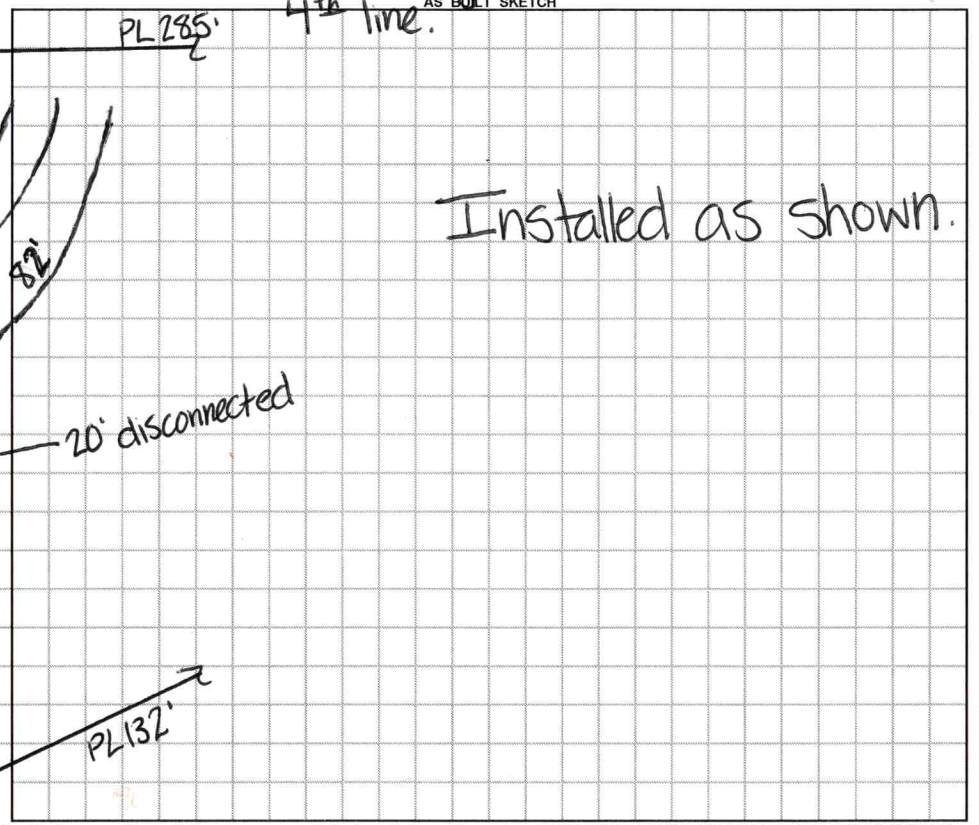

Permit can be suspended or revoked if any false information is supplied toward securing the permit / any unauthorized changes are made to the site / any unauthorized changes are made in the installation of the system. **CONTACT A LOCATOR SERVICE PRIOR TO ANY EXCAVATION**

☐ **IMPROVEMENT PERMIT** *with plat valid without expiration.* ☑ **IMPROVEMENT PERMIT** *with site plan valid for 60 mos.* ☑ **AUTHORIZATION TO CONSTRUCT** *valid for period equal to IMPROVEMENT PERMIT--not to exceed 60 mo.*

Owner / Applicant Signature: [signature] Date: 4-6-20 Installed by: 1st Choice Service

IMPROVEMENT PERMIT by: Kayla Watson Date: 4-6-20 OPERATION PERMIT by: Kayla Watson Date: 4-6-20

AUTHORIZATION TO CONSTRUCT by: Kayla Watson Date: 4-6-20 Existing System Inspected by: Date:

FOR SEPTIC FINAL INSPECTION: CALL 704-664-3703 between 8am-9am the day the inspection is needed. Be sure to speak with an inpsector to confirm your inspection time.

RECEIVED APR 06 2020 AP-306347 $150.00

APPLICATION MUST BE FILLED OUT COMPLETELY & BE LEGIBLE
OR IT WILL NOT BE PROCESSED

Iredell County Health Department – Environmental Health Division

PAGE 1: *APPLICATION FORM*

Application For: ( ) New Well Permit ( ) Well Repair Permit ( ) Well Abandonment
( ) Septic Improvement Permit ( ) Authorization to Construct ( ) Existing System Inspection (X) Septic System Repair

THE ABOVE PERMIT DOCUMENTS WILL BECOME INVALID IF INFORMATION PROVIDED ON THIS APPLICATION IS FALSIFIED OR CHANGED, OR IF THE SITE IS ALTERED. THE IMPROVEMENT PERMIT IS VALID FOR EITHER 60 MONTHS OR WITHOUT EXPIRATION DEPENDING UPON DOCUMENTATION SUBMITTED. APPLICATION WITH SITE PLAN 60 MONTHS, APPLICATION WITH COMPLETE, SCALED PLAT WITHOUT EXPIRATION. SEE 15A NCAC 18A .1937(f) FOR DETAILS.

Page 2: *Site Plan Worksheet* form MUST accompany this application

The following optional attachments may also be submitted: ( ) Survey Plat, scaled no more than 1 inch = 60 feet
Place an (X) beside whichever is submitted if applicable ( ) Custom Site Plan, scaled no more than 1 inch = 60 feet

Applicant Information: (PRINT CLEARLY)

Applicant Name: MIKE SWATSWORTH Address: 115 WEST COLD HOLLOW FARMS DR Zip: 28117
Applicant Email: mdswats@gmail.com Phone: (479) 418-3512 Alt. Phone: _____
Owner Name: MIKE SWATSWORTH Address: 115 WEST COLD HOLLOW FARMS DR Zip: 28117
Owner Email: mdswats@gmail.com Phone: (479) 418 3512 Alt. Phone: —

Property Information:

Street Address: 115 WEST COLD HOLLOW FARMS DR.
Subdivision Name: THE FARMS Section/Phase: 4 Lot Number: 476
Driving Directions: BRANCEY SCHOOL Rd → MCKENDREE Rd → BARE FOOT LN → W. COLD HOLLOW FARMS

Site Development Information: *(check or complete ALL that apply*

CHECK FOUNDATION TYPE

( ) New Single Family Residence — Maximum Number of Bedrooms: 4 — (X) Crawl Space Foundation
( ) New Multi-Family Residence — Maximum Number of Occupants: 5 — ( ) Concrete Slab Foundation
( ) Accessory Building — ( ) Swimming Pool — ( ) Basement with Plumbing
( ) Bedroom(s) Addition — ( ) Other Addition/Structure: _____ — ( ) Basement without Plumbing
(X) Repair to failing septic system ___ Tank X Drain lines Describe Problem: POOL CONSTRUCTION DAMAGED DRAIN LINE
Non-Residential Site Development: Type of Business: _____
Square Footage of Building: _____ Max. Number of Employees: _____ Max. Number of Seats/Beds/Other: _____

Water Supply: ( ) Replacement Well – Reason: _____
( ) Multi-connection Well Number of Houses: _____ Number of Persons: _____

( ) New Well ( ) Existing Well (X) Community Well ( ) City Water ( ) Other Public Water

Desired Septic System Type: *(you may rank in order of preference)* Year existing system installed: _____
( ) No Preference ( ) Alternative (X) Conventional ( ) Innovative ( ) Modified Conventional ( ) Other: _____

Please answer the following to the best of your ability:
( ) Yes (X) No Does the site contain any jurisdictional wetlands?
( ) Yes (X) No Is any non-domestic sewage (i.e. industrial) to be generated?
( ) Yes (X) No Is the site subject to approval by any other public agency?

I have read this application and certify that the information provided herein is true, complete, and correct. Authorized county and state officials are granted right of entry to conduct necessary inspections to determine compliance with applicable laws and rules. I understand that I am solely responsible for the proper identification and labeling of all property lines and corners and making the site accessible so that a complete site evaluation can be performed.

Signature: Michael D Swatsworth 3/25/2020
Property owner or owner's legal representative signature (SIGNATURE REQUIRED) DATE

Public Health
Iredell County Health Department

IREDELL COUNTY DEPARTMENT OF ENVIRONMENTAL HEALTH

Public Health
Iredell County Health Department

DOCUMENTATION TO AUTHORIZE AN OWNER'S LEGAL REPRESENTATIVE

(Check and sign only ONE of the options below)

X **1. * APPLICANT AND OWNER ARE THE SAME. *** (*Sign here*) Michele D Sutton

Applications for permits require the "signature of the owner or owner's legal representative" (15A NCAC 18A .1937). If the owner does not sign the application himself or herself, they can submit any one of the following documents to designate their legal representative: *Power of Attorney; Real Estate Contract; Estate executor; Bankruptcy trustee; Court ordered guardianship*
In the absence of the above documentation, the property owner may provide the local health department with documentation that designates a legal representative. A property owner may:
Complete this form to document his or her legal representative, or provide his or her own form that contains the information in this form. If there are multiple property owners, then all property owners must sign the form that designates a legal representative.
By signing a form that designates a legal representative for purposes of 15A NCAC 18A .1937, the property owner authorizes that representative to act on their behalf in matters pertaining to the application and permitting process, including signing or receiving any application, document or permit. The owner retains full responsibility to meet all permit conditions specified by the local health department.

2. I, _____, am the legal owner(s) of the property located at _____, identified as PIN (Parcel Identification Number) _____, located in Iredell County, North Carolina.

I do hereby authorize (**print legal representative/company name**) _____, _____, to act as an agent on my behalf in applying for/signing/obtaining any of the documents described below.

- Application for Improvement Permit (IP) / Authorization to Construct (AC)
- Improvement Permit (IP) / Authorization to Construct (AC)
- Application for soil-site evaluation (new/repair)
- Application/permit for private drinking water well/well abandonment
- Application for Compliance Inspection

I agree to abide by all decisions and/or conditions between the legal representative acting on my behalf and the Iredell County Department of Public Health, Environmental Health Division.


Michele D Sutton — Signature of Owner(s)

3/25/20 — Date

Mooresville - Environmental Health

Fax: 704-662-3239
610 E. Center Avenue, Mooresville, NC 28115

Statesville - Environmental Health
ronda.hart@co.iredell.nc.us
Fax: 704-871-3483
349 N. Center Street, Statesville, NC 28677

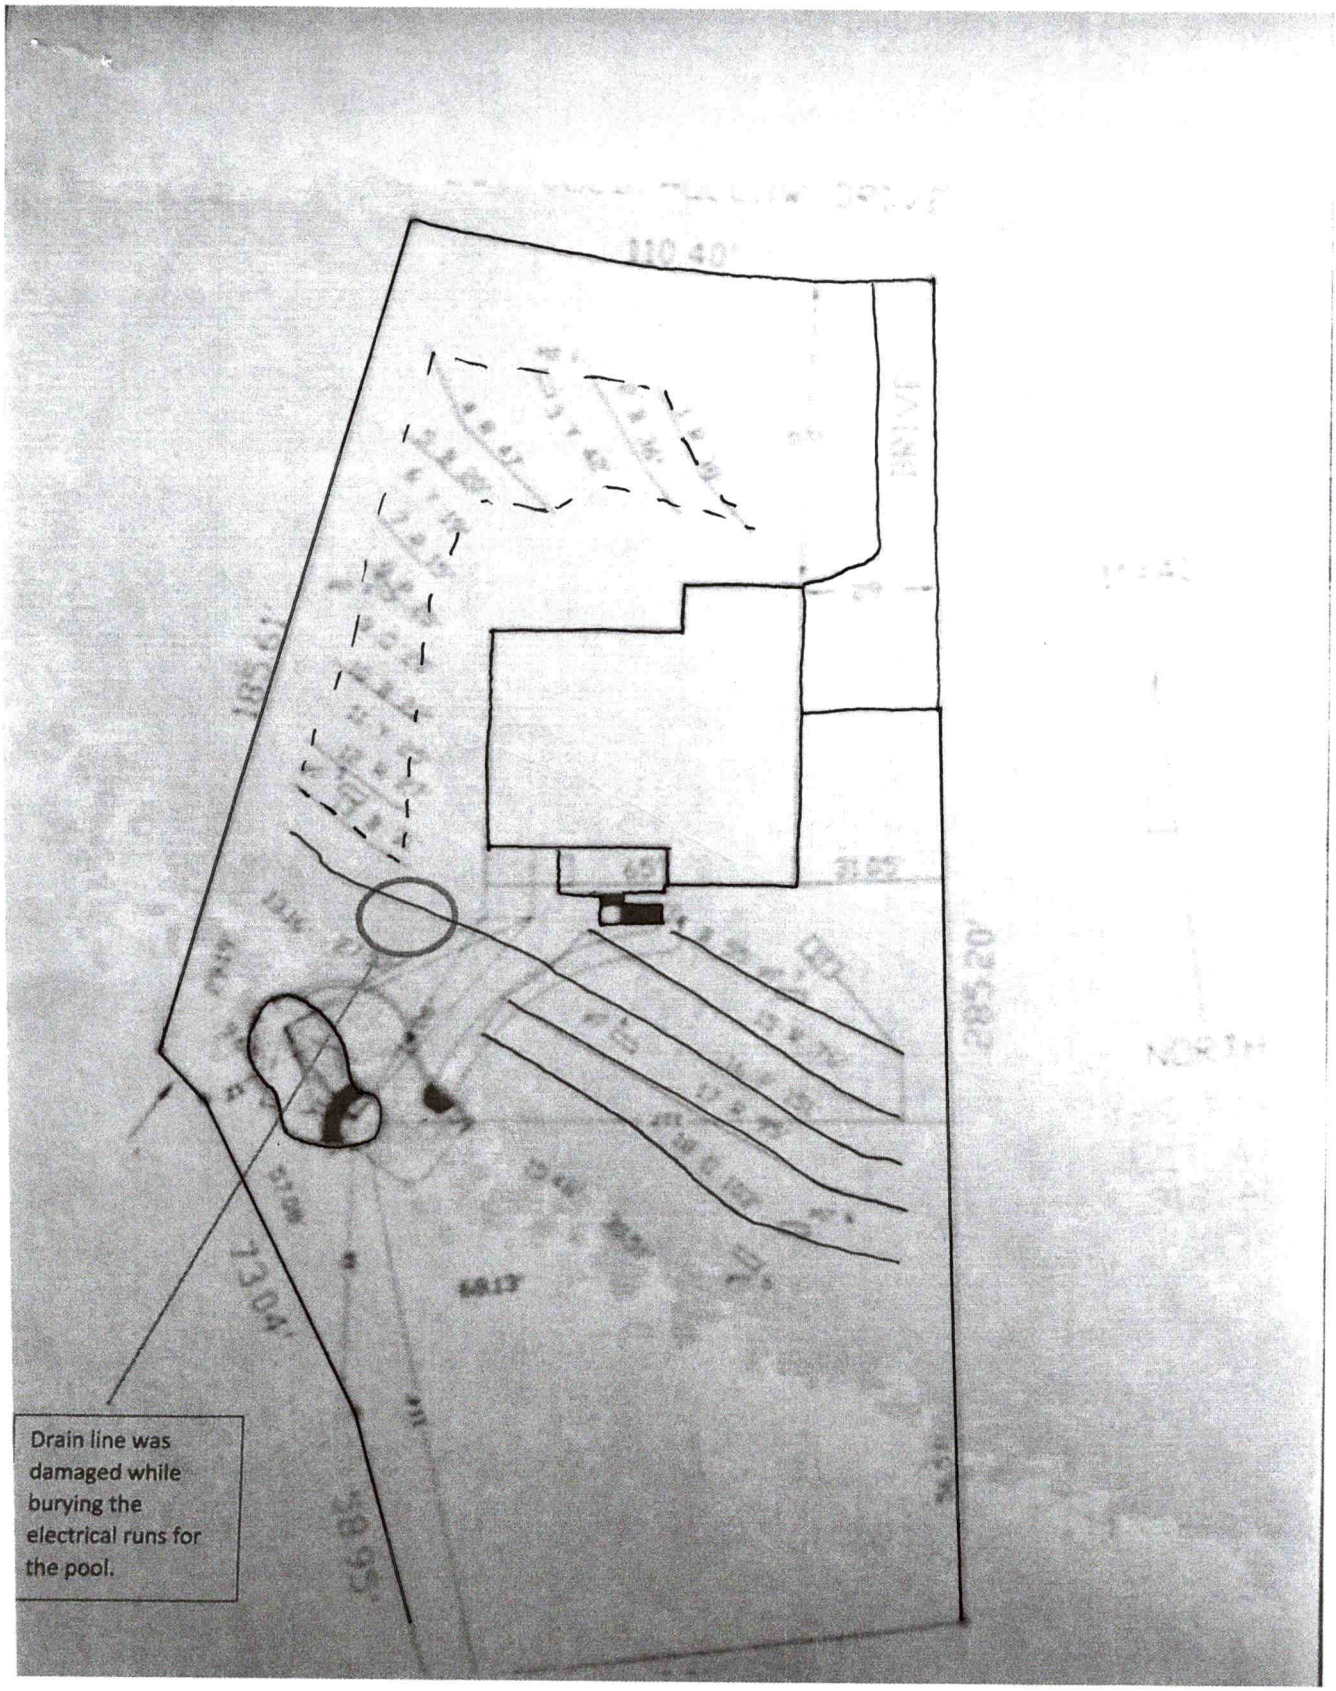
110.40'
285.20'
Drain line was damaged while burying the electrical runs for the pool.