IREDELL COUNTY HEALTH DEPARTMENT

STATESVILLE 704-878-5305 MOORESVILLE 704-664-5281

IMPROVEMENT PERMIT / AUTHORIZATION TO CONSTRUCT / OPERATION PERMIT / EXISTING SYSTEM INSPECTION

PERMIT# 118578 PIN# 4626088038 DATE 12-28-06

OWNER OR APPLICANT D.S. Rushing Inc PHONE: Business 704-896-5766 Home

ADDRESS 221 Beracah Rd

LOCATION Brawley School Rd TR McKendree .3 mi. on left just past Bayberry Creek Circle

SUBDIVISION The Farms BLOCK / SECTION 3 LOT 302 LOT AREA .96 Ac SITE CLASS. ES DESIGN FLOW 480 gpd L.T.A.R. .3 gpd/ft2

Septic Tank: ~~1000~~ 1500 Gallons; STB 444 Date 3-10-07

Pump Tank: ~~1000~~ 1500 Gallons; PT 477 Date 3-11-07

Pump Make: Model Serial No.

Nitrification Field: No Fields 1 Square Feet 1600 Linear Feet 400

No Lines 4@100' Trench Width 36" Max Trench Bottom Depth 36"

☒ New System ☐ Repair ☐ Expansion System Type: I II (III) IV V VI

System Description: 25% reduction pm

Repair System Description: LP panel

Maintenance Agreement Required: ☐ Yes ☒ No

Gravel Depth NA ☐ Gravity ☒ Pressure ☐ Slab ☒ Crawl Space ☐ Basement w/plumbing ☐ Basement wo/plumbing

☒ House/Mod. Home No. Bedrooms 4

☐ Mobile Home No. Persons 8

☐ Business No. Employees

☐ Other

Water Supply: ☐ Individual ☐ Public ☒ Community


Comments:/Conditions:

Comments:/Conditions:


Red Poly lok filter

1" = 50'

INITIAL SITE SKETCH

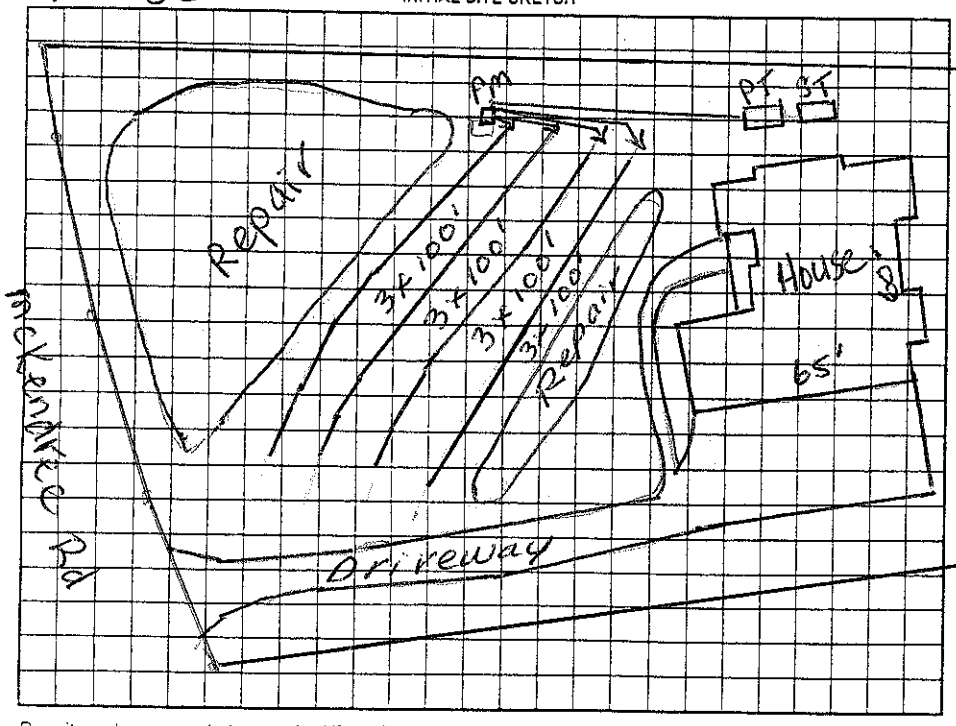

AS BUILT SKETCH

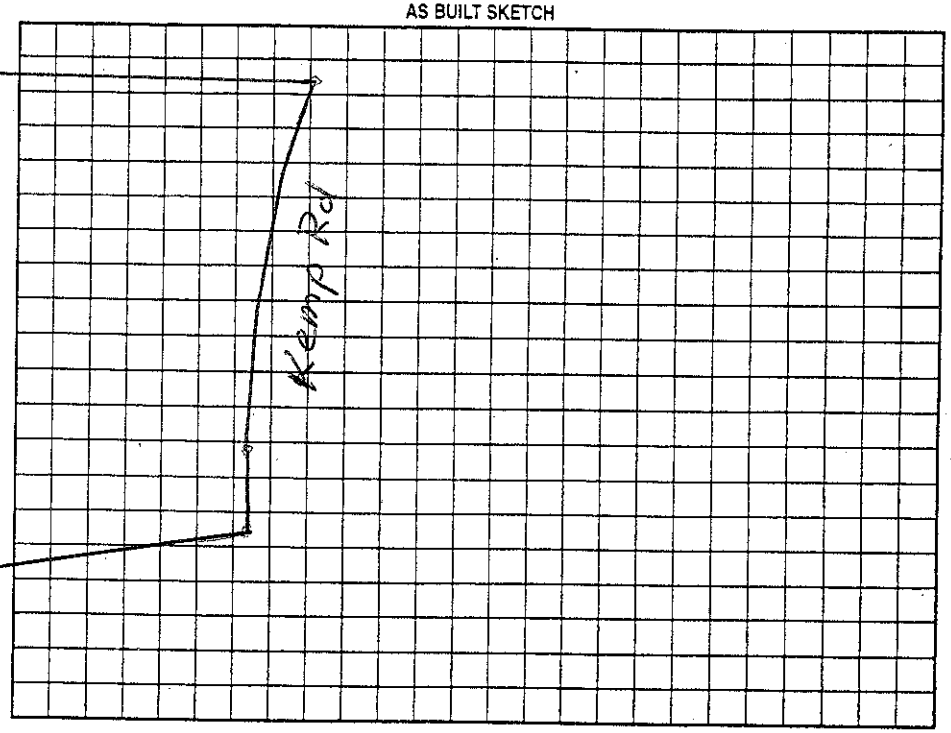

Permit can be suspended or revoked if any false information is supplied toward securing the permit/any unauthorized changes are made to the site/any unauthorized changes are made in the installation of the system. Improvement Permit with plat valid without expiration ☐ Improvement Permit with site plan valid for sixty months ☒ Authorization to Construct is valid for a period equal to that of Improvement Permit – not to exceed sixty months.

Signed: Sharon Rushing date 12-29-06 Installed by: Larry Tucker 791-4652

Improvement Permit by: Judy Melville date 12-28-06 Operation Permit by: Wesley Sparks ES date 6/28/07

Authorization to Construct by: Judy Melville date 12-28-06 Existing System Inspection by: date

HEALTH DEPT. COPY: WHITE OWNER COPY (FINAL): YELLOW OWNER COPY (INITIAL): PINK