IREDELL COUNTY HEALTH DEPARTMENT

Statesville Office (704) 878-5305 Mooresville Office (704) 660-3625

2130

PERMIT # 131275

IMPROVEMENT PERMIT / AUTHORIZATION TO CONSTRUCT / OPERATION PERMIT / EXISTING SYSTEM

PIN # 4626088835

APPLICANT: ES JOHNSON BUILDERS APPLICANT ADDRESS: PO BOX 1402 CORNELIUS NC 28031

SITE ADDRESS: 102 W COLD HOLLOW FARMS MOORESVILLE PHONE: ALT. PHONE: 704 987 7950

SITE DIRECTIONS: BRAWLEY SCHOOL RD - TR MCENDREE - TR BAREFOOT LN - @ STRAIGHT AHEAD AT END

SUBDIVISION: FARMS SECTION: 4 LOT # 483 LOT AREA: .922 DESIGN FLOW: 600 L.T.A.R.: .256 AFA

Septic Tank 1500 (gal) STB 338 Date 9-3-14

Pump Tank 1500 (gal) PT 971 Date 10-3-14

Pump Make Myers Model ME0512HH Serial #

Nitrification Fields 1 # Lines 4 Linear Ft: 400

Trench Width 24" min Max. Trench Bottom Depth 36" Gravel Depth N/A

☑ New System ☐ Repair ☐ Expansion System Type: I II III (IV) V VI

System Description: LP PPBPS

Repair System Description: LP PPBPS

Maintenance Agreement Required: ☐ YES ☐ NO ☐ GRAVITY ☑ PRESSURE

☑ Residence No. Bedrooms 5

☐ Business No. Persons 10

☐ Other No. Employees

☐ Slab ☑ Crawl Space


☐ Basement w/plumbing ☐ Basement w/o plumbing

Water Supply: ☐ Private ☐ Public ☑ Community


Comments / Conditions: 11/12/14 Checked tanks, lines & set pressure. MS

Drilled 5/32" hole ST 29ft from house Installed Quick & essentially as Drawn Electric Alarm checked 11/20/14

INITIAL SITE SKETCH

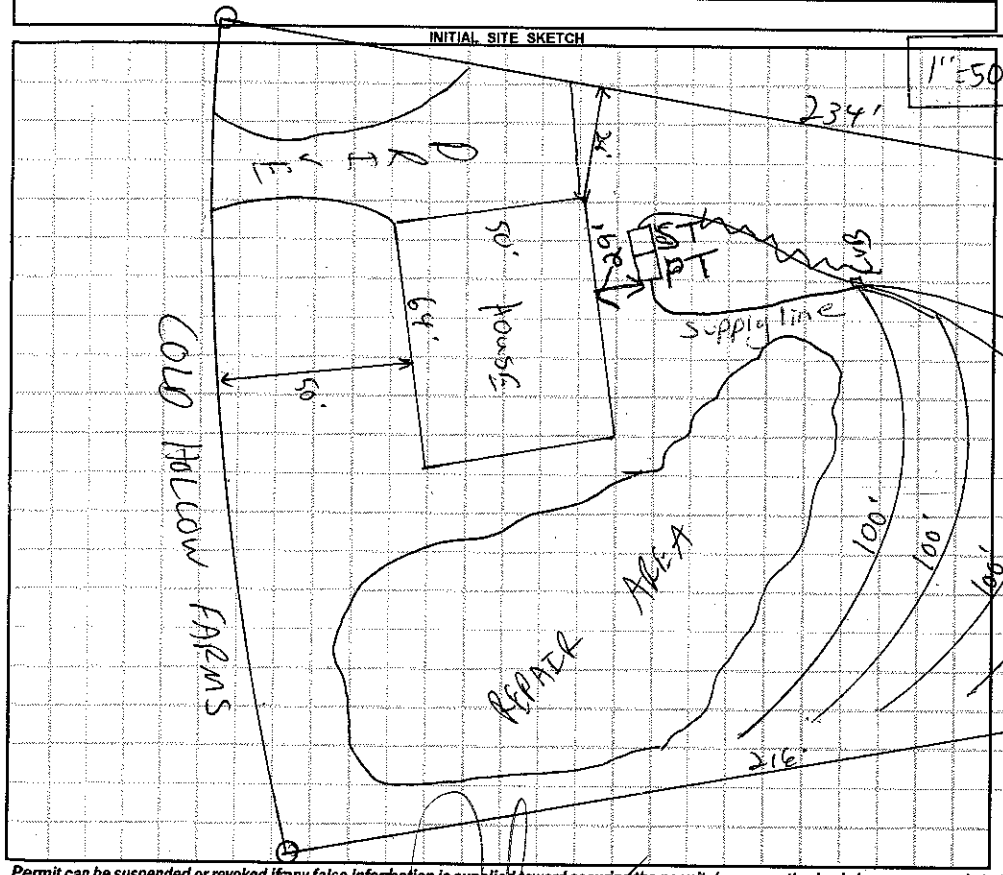

AS BUILT SKETCH

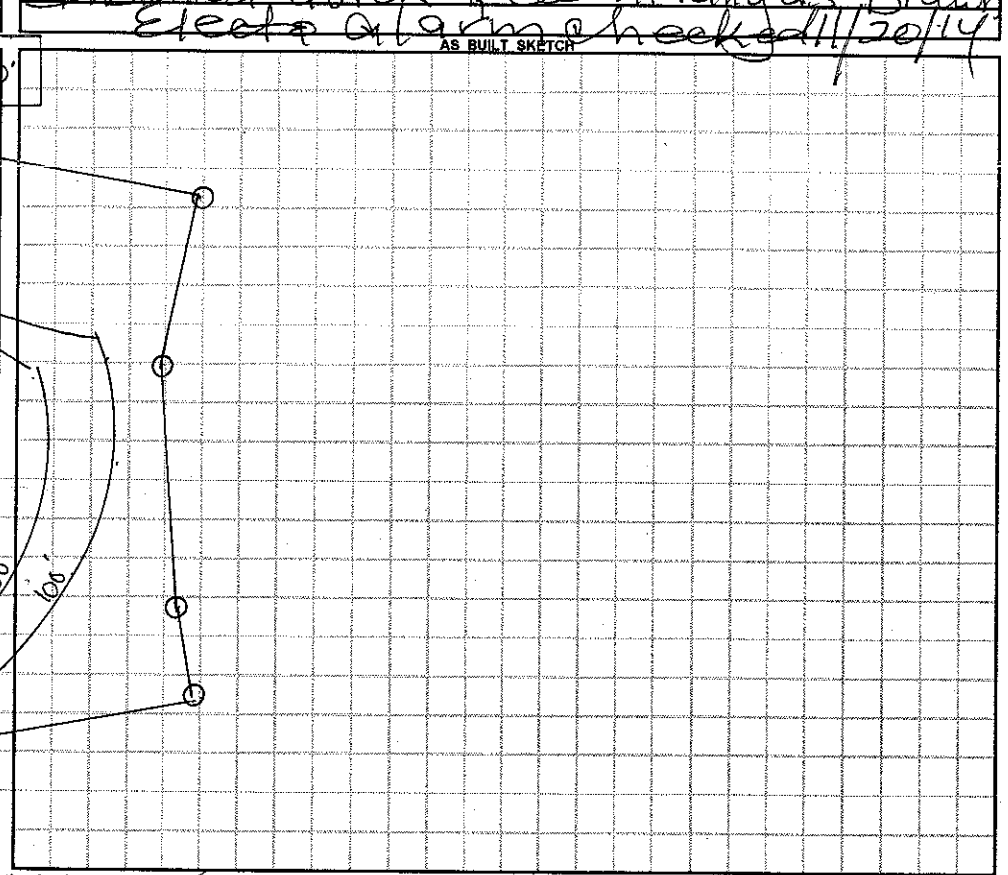

Permit can be suspended or revoked if any false information is supplied toward securing the permit / any unauthorized changes are made to the site / any unauthorized changes are made in the installation of the system. **CONTACT A LOCATOR SERVICE PRIOR TO ANY EXCAVATION**

☐ **IMPROVEMENT PERMIT** *with plat valid without expiration.* ☑ **IMPROVEMENT PERMIT** *with site plan valid for 60 mos.* ☑ **AUTHORIZATION TO CONSTRUCT** *valid for period equal to IMPROVEMENT PERMIT--not to exceed 60 mo.*

Owner / Applicant Signature: Date:

IMPROVEMENT PERMIT by: REHS Date: 1/25/13

AUTHORIZATION TO CONSTRUCT by: REHS Date: 1/25/13

Installed by: Willie Christenbury

OPERATION PERMIT by: Mary Jo Johnson RS Date: 11/20/14

Existing System Inspected by: Date:

Health Dept. Copy - WHITE Applicant (Final Approval) - YELLOW Applicant (Conditional Approval) - PINK