IREDELL COUNTY HEALTH DEPARTMENT

Statesville Phone TR 3-7271 Mooresville Phone No. 664-5231

PERMIT TO INSTALL SEPTIC TANK

Permit No. 201 Permit Date 8-14-1973

Owner Jim Thomason Address Charlotte

Installed By F. J. Ervin Address Mooresville


Location of Property 1100 TL on 1112 Then TL into Norman Woods First House on left Sec 8 Lot 257

Tank		Capacity		Length of Lines		Fixtures	
Block	( )	1000	( )	225'	( )	No. of Baths	(5)
Precast	(✓)	1250	(✓)	250'	( )	Dishwasher	(yes
		1500	( )	Other 320		Garbage Grdr.	(yes
		Other				Other Washing machine	

NOTIFY HEALTH DEPARTMENT AT LEAST EIGHT HOURS BEFORE TANK IS TO BE INSPECTED.

Final Inspection 8-14-1973 Approved (✓) Disapproved ( )

Remarks

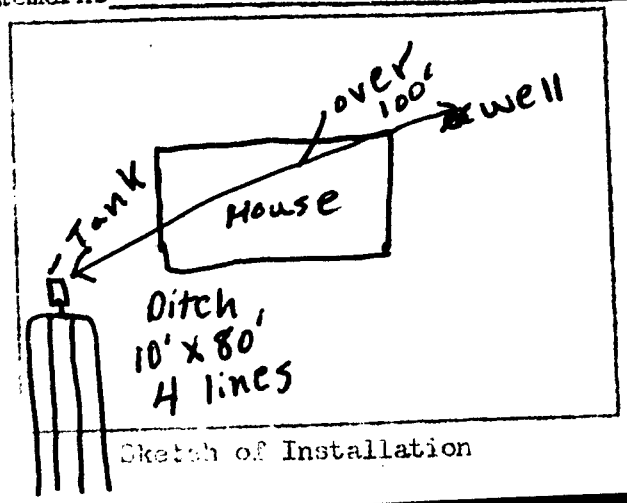

Sketch of Installation

F. C. Moore

Sanitarian