11:00

IREDELL COUNTY HEALTH DEPARTMENT

STATESVILLE 704-878-5305 MOORESVILLE 704-664-5281

IMPROVEMENT PERMIT / AUTHORIZATION TO CONSTRUCT / OPERATION PERMIT / EXISTING SYSTEM INSPECTION

PERMIT# 083450 PIN# 4626096194 DATE 4-12-2001

OWNER OR CONTRACTOR Robert Davis (Curtis Batten) PHONE: Business (336)766-3300 Home 774-1830 (336)382-2932 Curtis

ADDRESS 18807 W. Cabral St. Canyon (County, CA 91351

LOCATION Brawley School Rd TR 8 McKendree TR 1st Lakeview Shore Loop TL Abbot TL Lakeview Shore

SUBDIVISION CL & T BLOCK / SECTION 8 LOT 1625 LOT AREA ~1.15 Acre SITE CLASS PS DESIGN FLOW 360 gpd L.T.A.R. .3 LP#1625

Septic Tank: 1000 Gallons; STB 794 Date 9-8-01

Pump Tank: 1000 Gallons; PT 27 Date 7-16-01

Pump Make: Meyers Model Me50 Serial No.

Nitrification Field: No Fields 1 Square Feet 900' Linear Feet 300'

No Lines 4 Trench Width 36" Max Trench Bottom Depth 36" Gravel Depth N/A

[X] New System [ ] Repair System Type: I, II, III, IV, V, VI

System Description: Pump-PM-25% Reduction

Repair System Description: Pump (LP)

Maintenance Agreement Required: [ ] Yes [X] No

[X] House/Mod. Home [ ] Mobile Home [ ] Business [ ] Other

No. Bedrooms 3 No. Bathrooms 3 No. Employees

[ ] Slab [ ] Crawl Space [X] Basement w/plumbing [ ] Basement wo/plumbing


Water Supply: [X] Individual [ ] Public [ ] Community

Comments:/Conditions: Keep Septic System at least 10' From PL, 50' from lake & 50' From any well

Comments:/Conditions: Keep well at least 25' From House & 50' From any Septic System.

Checked tanks & lines 10/10/2001

INITIAL SITE SKETCH

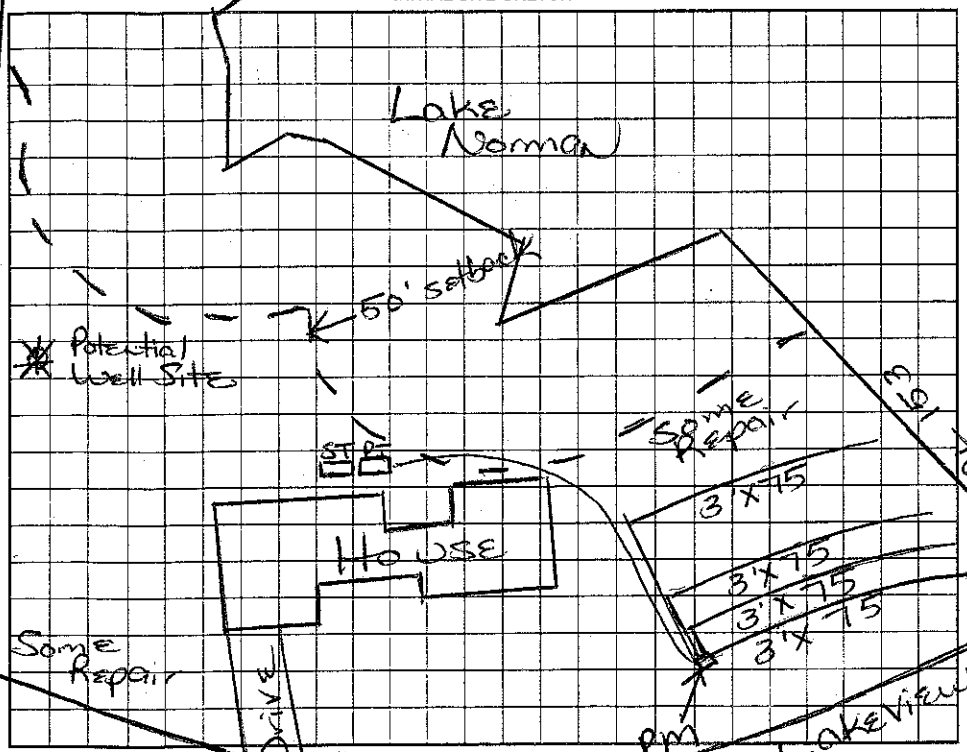

AS BUILT SKETCH

E.Z Flow lines installed.

Permit can be suspended or revoked if any false information is supplied toward securing the permit/any unauthorized changes are made to the site/any unauthorized changes are made in the installation of the system. Improvement Permit with plat valid without expiration. Improvement Permit with site plan valid for sixty months. Authorization to Construct is valid for a period equal to that of Improvement Permit – not to exceed sixty months.

Signed: Curtis Batten date

Improvement Permit by: Maria H. Holcomb RS. date 4/12/2001

Authorization to Construct by: Maria H. Holcomb RS. date 4/12/2001

Installed by: R & H

Operation Permit by: Maria H. Holcomb RS. date 11/19/2001

Existing System Inspection by: date

HEALTH DEPT. COPY: WHITE OWNER COPY (FINAL): YELLOW OWNER COPY (INITIAL): PINK