Site Address: 135 Pentland Court

3:30

IREDELL COUNTY HEALTH DEPARTMENT

STATESVILLE 704-878-5305 MOORESVILLE 704-664-5281

IMPROVEMENT PERMIT / AUTHORIZATION TO CONSTRUCT / OPERATION PERMIT / EXISTING SYSTEM INSPECTION

PERMIT # 152701 PIN # 4621-09-6935 DATE 11-14-08

OWNER or APPLICANT JOHN RUFTY PHONE: Business Home: 704-310-4110

OWNER or APPLICANT ADDRESS 150 PENTLAND CT MOORESVILLE

LOCATION / DIRECTIONS MCKEENDREE, TR LAKEVIEW SHORES, TL ABBOT, TL LAKEVIEW SHORES, TR PENTLAND

SUBDIVISION CLFT BLOCK / SECTION 8 LOT # 258 LOT AREA .82AC DESIGN FLOW 360 L.T.A.R. .35

Septic Tank 1000 Gallons: STB 1160 Date 10-1-08

Pump Tank 1000 Gallons: PT 319 Date 11-6-08

Pump Make Model Serial #

Nitrification Field No Fields 1 No Lines 5 Linear Feet 216'

Trench Width 24-36" Max. Trench Bottom Depth 36" Gravel Depth —

☒ New System ☐ Repair ☐ Expansion System Type I II III IV V VI

System Description: LP - PANEL BLOCK

Repair System Description: SAME

Maintenance Agreement Required ☒ YES ☐ NO

☐ GRAVITY ☒ PRESSURE


☒ Residence No. Bedrooms 3 ☐ Business No. Persons ☐ Other No. Employees ☐ Slab ☒ Crawl Space ☐ Basement w/plumbing ☐ Basement w/o plumbing

Water Supply: ☒ Private ☐ Public ☐ Community


Comments / Conditions

Comments / Conditions 1) INSTALLED AS SHOWN 1/13/2009 Tanks, Drainlines, Pressure, Elect. & Alarm checked by BA

INITIAL SITE SKETCH

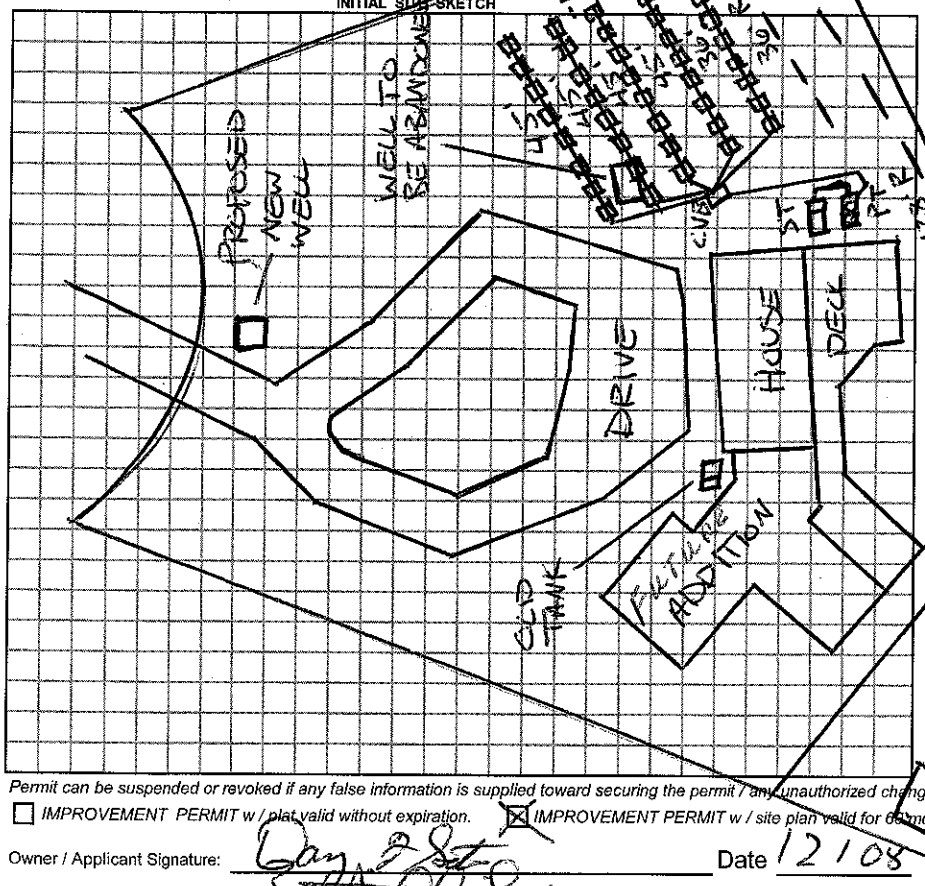

AS BUILT SKETCH

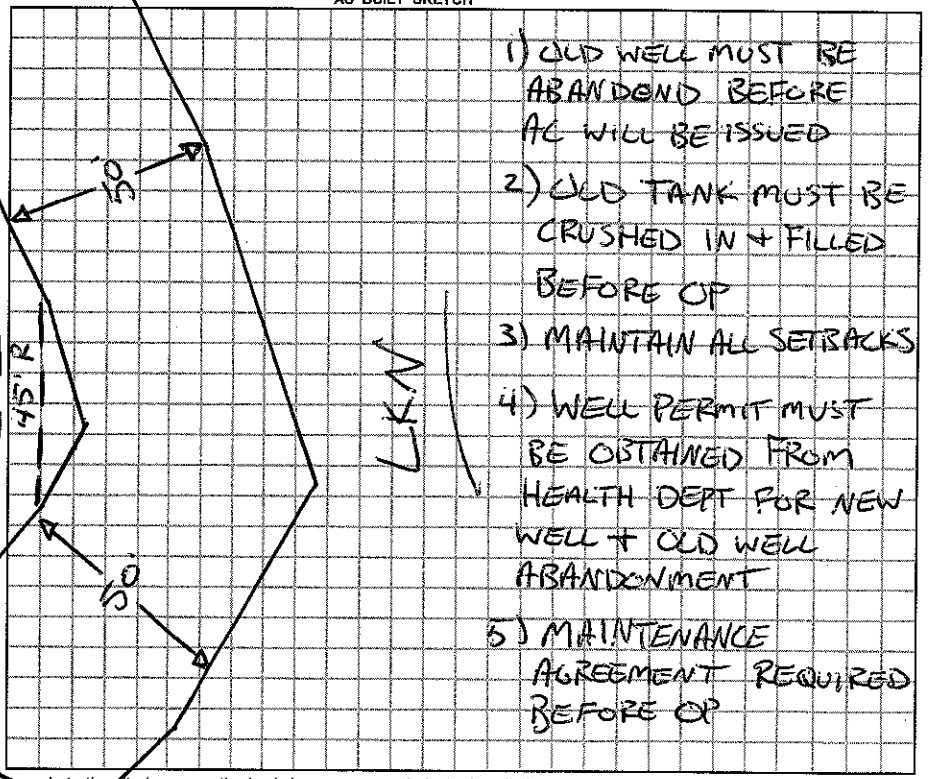

1) OLD WELL MUST BE ABANDOND BEFORE AC WILL BE ISSUED
2) OLD TANK MUST BE CRUSHED IN + FILLED BEFORE OP
3) MAINTAIN ALL SETBACKS
4) WELL PERMIT MUST BE OBTAINED FROM HEALTH DEPT FOR NEW WELL + OLD WELL ABANDONMENT
5) MAINTENANCE AGREEMENT REQUIRED BEFORE OP

Permit can be suspended or revoked if any false information is supplied toward securing the permit / any unauthorized changes are made to the site / any unauthorized changes are made in the installation of the system.

☐ *IMPROVEMENT PERMIT w / plat valid without expiration.* ☒ *IMPROVEMENT PERMIT w / site plan valid for 60 mos.* ☒ *AUTHORIZATION TO CONSTRUCT valid for period equal to IMPROVEMENT PERMIT-not to exceed 60 mo.*

Owner / Applicant Signature: Date 12/08

Improvement Permit by: Date 11-14-08

Authorization to Construct by: Date 12-1-08

YOU SHOULD CONTACT A LOCATOR SERVICE PRIOR TO ANY EXCAVATION.

Installed by: BOAT STORAGE Gary Leatherman

Operation Permit by: RS Date: 3/3/2010

Existing System Inspected by: Date:

WHITE COPY Environmental Health YELLOW COPY (Final) Owner / Applicant PINK COPY (Initial) Owner / Applicant