4626097544

IREDELL COUNTY HEALTH DEPARTMENT

STATESVILLE 704-878-5305 MOORESVILLE 704-664-5281

IMPROVEMENT PERMIT / CERTIFICATE OF COMPLETION / OPERATION PERMIT / EXISTING SYSTEM INSPECTION

PROPERTY DESCRIPTION NO. 16655 DATE July 14, 93 TAX MAP NO. 2L3A 255

OWNER OR CONTRACTOR Donald A. Wimbish PHONE: Business Home

ADDRESS 4015 Ivy Oaks Ct. Charlotte 28227

LOCATION 160 TR 413 TR 1453 (Lakeview) TL Abbot TL Lakeview 1/4 mile TR Pentland on left

SUBDIVISION Crescent Lake Woman BLOCK / SECTION 8 LOT 255 LOT AREA SITE CLASS. L.T.A.R.

Water Supply: ☑ Individual ☐ Community ☐ Public

Septic Tank: Existing (1000) Gallons; STB Date

Pump Tank: 0 Gallons; PT Date

Nitrification Field: No Fields 1 Square Feet 240 Linear Feet 80

No Lines 1+E Trench Width 36" Trench Depth 30" Gravel Depth 12"

☐ New System ☑ Repair System Type: I, (II), III, IV, V, VI

System Description:

Repair System Description: grav. conv.

Maintenance Agreement Required: ☐ Yes ☑ No LATE

☑ House/Mod. Home ☐ Mobile Home ☐ Business ☐ Other

No. Bedrooms 2 No. Bathrooms 2 No. Employees

☐ Slab ☑ Crawl Space ☐ Basement w/plumbing

Garbage Disposal: ☑ Yes ☐ No

Auto. Dishwasher: ☑ Yes ☐ No


Auto. Washing Machine: ☑ Yes ☐ No

Other


☐ Basement wo/plumbing

Comments: Upper original line to be disconnected & abandoned. Future home to be set at least 5' off septic system. Upper existing line abandoned. 2nd line cut off 5' from porch

INITIAL SITE SKETCH

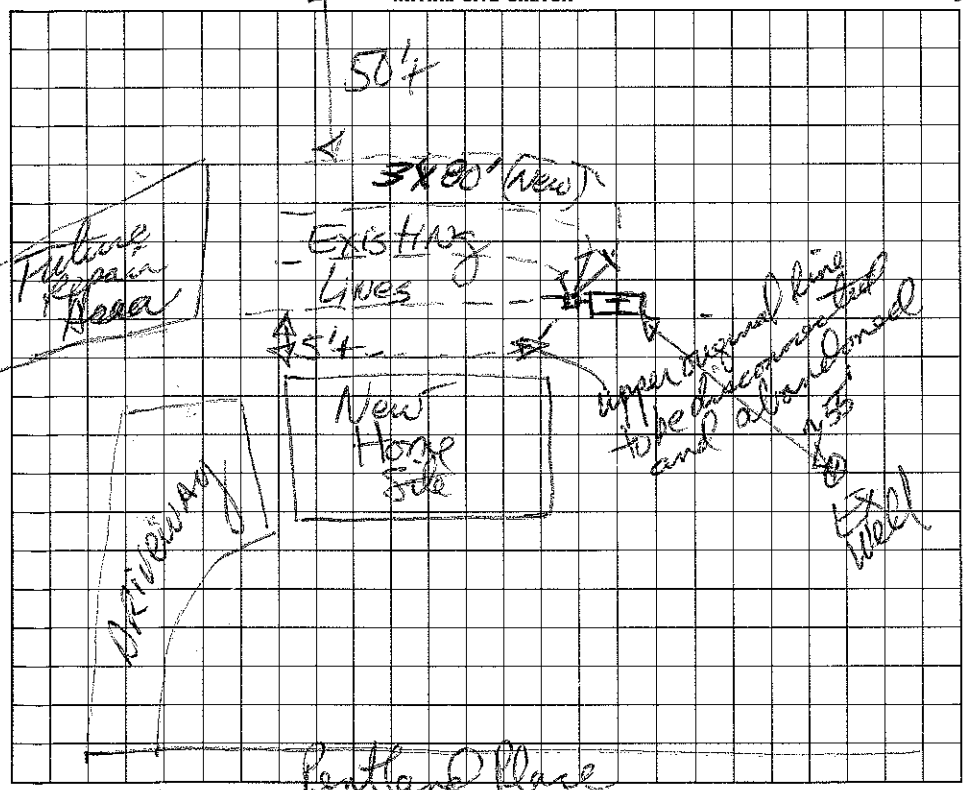

AS BUILT SKETCH

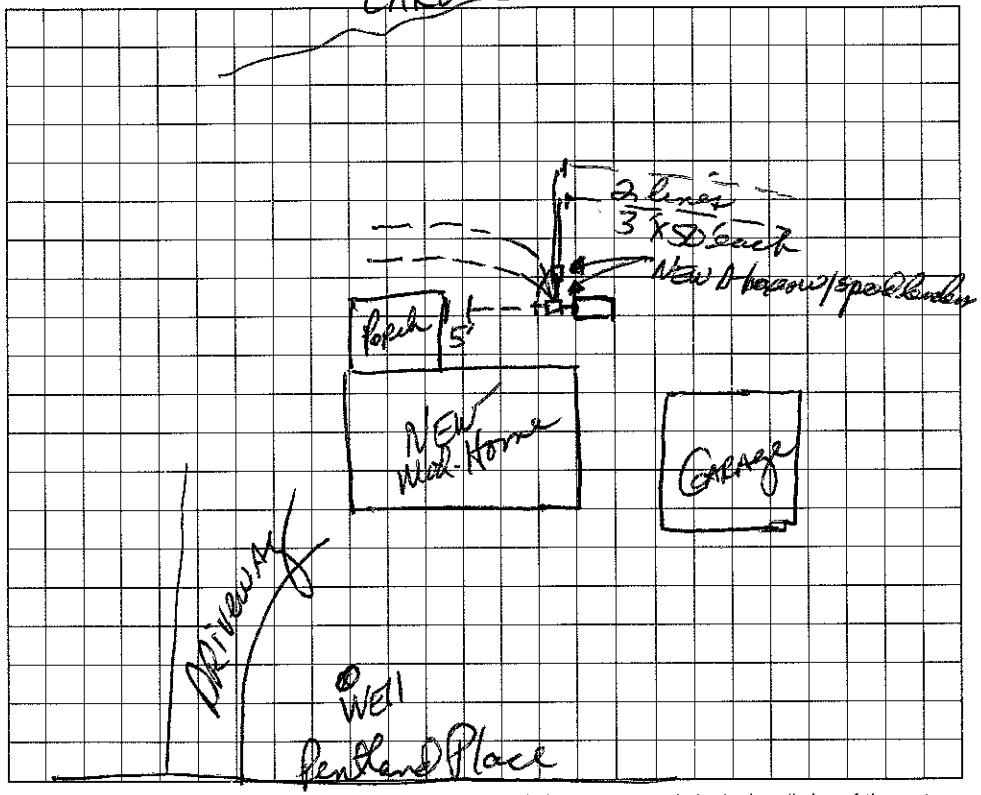

I understand that this permit can be suspended or revoked if any false information is supplied toward securing the permit/any unauthorized changes are made to the site/any unauthorized changes are made in the installation of the system. Improvement Permit is valid for 60 months from date of issuance.

Signed:

Improvement Permit by: Jane Hanson IRS date 7/14/93

Existing System Inspection by: date

Installed by: Bill Leighton

Certificate of Completion by: Jane Hanson IRS date 9/7/93

Operation Permit by: date

HEALTH DEPT. COPY: WHITE INSPECTION COPY (FINAL): GREEN OWNER COPY (FINAL): YELLOW INSPECTION COPY (INITIAL): PINK OWNER COPY (INITIAL): GOLD