IREDELL COUNTY HEALTH DEPARTMENT

Statesville Phone TR 3-7271 Mooresville Phone NO 3-1271

PERMIT TO INSTALL SEPTIC TANK

Permit NO. _____ Permit Date 1 Aug 1969

Owner J. W Lowe Address Landis N.C.

Installed By Hubbard Address Kannapolis, NC


Location of Property Knapolis Ser. Sect 7 Lot 148

Tank		Capacity		Length of Lines		Fixtures	
Block	( )	1000	(✓)	225'	(✓)	No. of Baths	( )
Precast	(✓)	1250	( )	250'	( )	Dishwasher	( )
		1500	( )	Other _____		Garbage Grdr.	( )
		Other _____				Other _____	

NOTIFY HEALTH DEPARTMENT AT LEAST EIGHT HOURS BEFORE TANK IS TO BE INSPECTED.

Final Inspection 1 Aug 1969 Approved (X) Disapproved ( )

Remarks Top Section of Tank Cracked

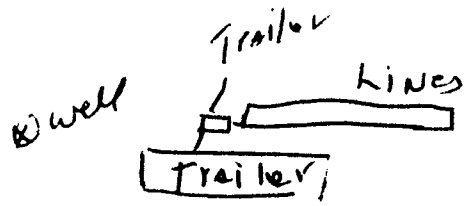

Sketch of Installation

Troy R. Scoggins

Sanitarian