1:30

IREDELL COUNTY HEALTH DEPARTMENT

Statesville Office (704) 878-5305 Mooresville Office (704) 660-3625 PERMIT # 20192

IMPROVEMENT PERMIT / AUTHORIZATION TO CONSTRUCT / OPERATION PERMIT / EXISTING SYSTEM

PIN # 4626-10-0361

APPLICANT: LAKE LUXURY HOMES APPLICANT ADDRESS: PO BOX 3792 MULLIE

SITE ADDRESS: 247 BARBER LOOP PHONE: 704-516-2344 ALT. PHONE:

SITE DIRECTIONS: BSR, TR CHUCKWOOD, TL 1ST BARBER, ON L

SUBDIVISION: CLET SECTION: 7 LOT # 148 LOT AREA: DESIGN FLOW: 480 L.T.A.R.: .5

Septic Tank EXISTING (gal) STB 825 Date 4-2-14
Pump Tank EXISTING (gal) PT 302 Date 6-11-14
Pump Make Zoeller Model N152 Serial #
Nitrification Fields 1 # Lines 4 Linear Ft: 180'
Trench Width 24" Max. Trench Bottom Depth 36" Gravel Depth —


☐ New System ☐ Repair ☒ Expansion System Type: I II III (IV) V VI
System Description: LP GRAVEL + LP PANEL
Repair System Description: LP PANEL
Maintenance Agreement Required: ☒ YES ☐ NO ☐ GRAVITY ☒ PRESSURE

☒ Residence No. Bedrooms 4
☐ Business No. Persons
☐ Other No. Employees
☐ Slab ☐ Crawl Space
☒ Basement w/plumbing ☐ Basement w/o plumbing


Water Supply: ☒ Private ☐ Public ☐ Community

Comments / Conditions: Drilled 5/32" hole, checked tanks, lines & pressure 8/6/14
2FT.
Remove exist bed within 5FT of Front PL
Ran supply line thru old tank area, pumped out, Crushed & bank filled

INITIAL SITE SKETCH

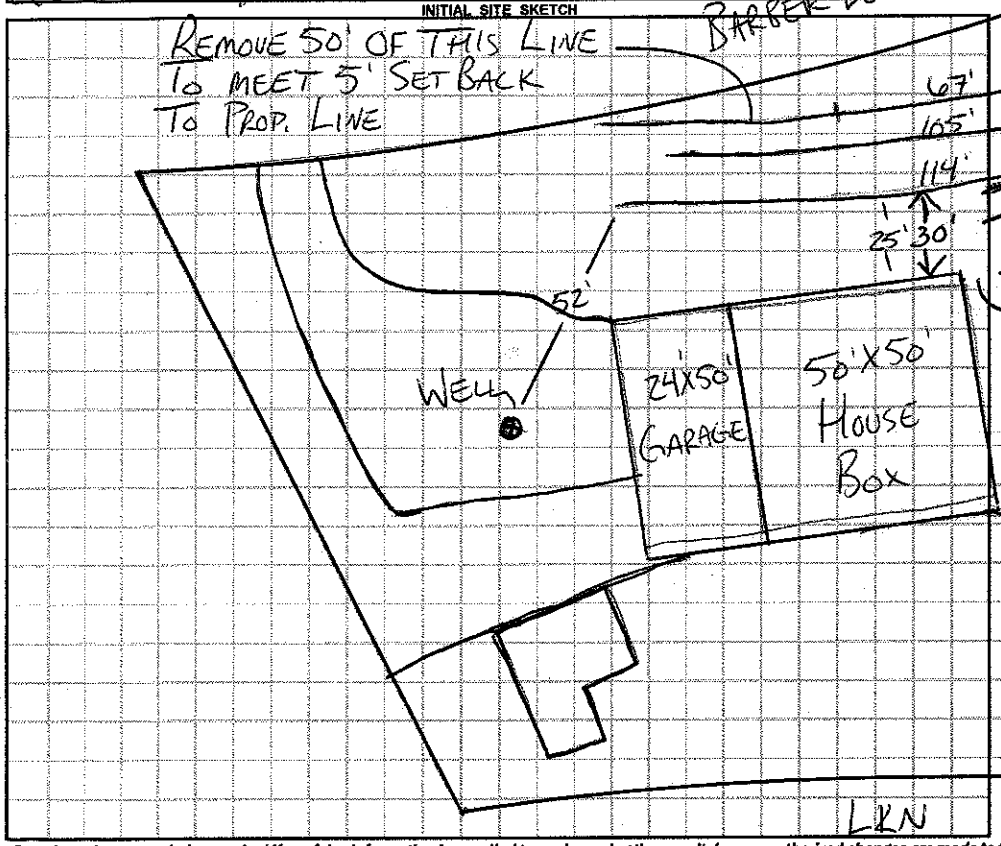

AS BUILT SKETCH

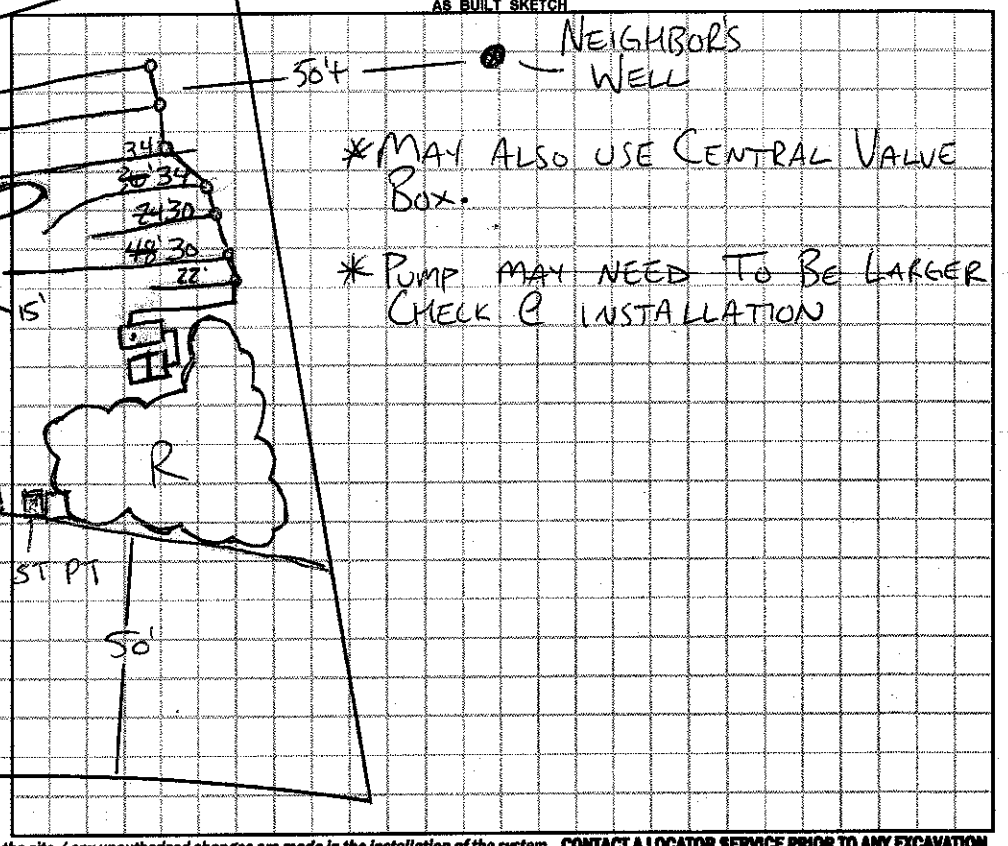

Permit can be suspended or revoked if any false information is supplied toward securing the permit / any unauthorized changes are made to the site / any unauthorized changes are made in the installation of the system. **CONTACT A LOCATOR SERVICE PRIOR TO ANY EXCAVATION**

☐ **IMPROVEMENT PERMIT** ~~with plat~~ valid without expiration. ☒ **IMPROVEMENT PERMIT** *with site plan* valid for 60 mos. ☐ **AUTHORIZATION TO CONSTRUCT** valid for period equal to IMPROVEMENT PERMIT--not to exceed 60 mo.

Owner / Applicant Signature: Date: 2-19-14 Installed by: Rowan Septic

IMPROVEMENT PERMIT by: Date: 2-19-14 OPERATION PERMIT by: RS Date: 8/12/14

AUTHORIZATION TO CONSTRUCT by: APPROVED FEB 20 2014 Existing System Inspected by: Date:

Health Dept. Copy - WHITE Applicant (Final Approval) - YELLOW Applicant (Conditional Approval) - PINK