IREDELL COUNTY HEALTH DEPARTMENT

Statesville Office (704) 878-5305 Mooresville Office (704) 660-3625 PERMIT # NP 14887Z

IMPROVEMENT PERMIT / AUTHORIZATION TO CONSTRUCT / OPERATION PERMIT / EXISTING SYSTEM

PIN # 4626-10-0861

APPLICANT: LAKE LUXURY HOMES APPLICANT ADDRESS: PO BOX 3792 MULLE

SITE ADDRESS: 588 BARBER LOOP PHONE: 704-510-2344 ALT. PHONE:

SITE DIRECTIONS: BSR, CHUCKWOOD, TL BARBER LOOP, ON R


SUBDIVISION: WATERTREE LANDING SECTION: LOT # 67 LOT AREA: .69 AC DESIGN FLOW: 480 L.T.A.R.: .25

Septic Tank	1000	(gal)	STB		Date		☑ New System	☐ Repair	☐ Expansion	System Type: I II (III) IV V VI	
Pump Tank		(gal)	PT		Date		System Description:	25% REDUCTION			
Pump Make		Model			Serial #		Repair System Description:	PANEL			
# Nitrification Fields	1	# Lines	6 @ 80'		Linear Ft:	480'	Maintenance Agreement Required:	☐ YES	☑ NO		
Trench Width	36"	Max. Trench Bottom Depth	36"		Gravel Depth	—		☑ GRAVITY	☐ PRESSURE		

☑ Residence	No. Bedrooms	4	Water Supply
☐ Business	No. Persons		☑ Private
☐ Other	No. Employees		☐ Public
☐ Slab	☑ Crawl Space		☐ Community
☐ Basement w/plumbing			☐ Basement w/o plumbing

Comments / Conditions:

INITIAL SITE SKETCH

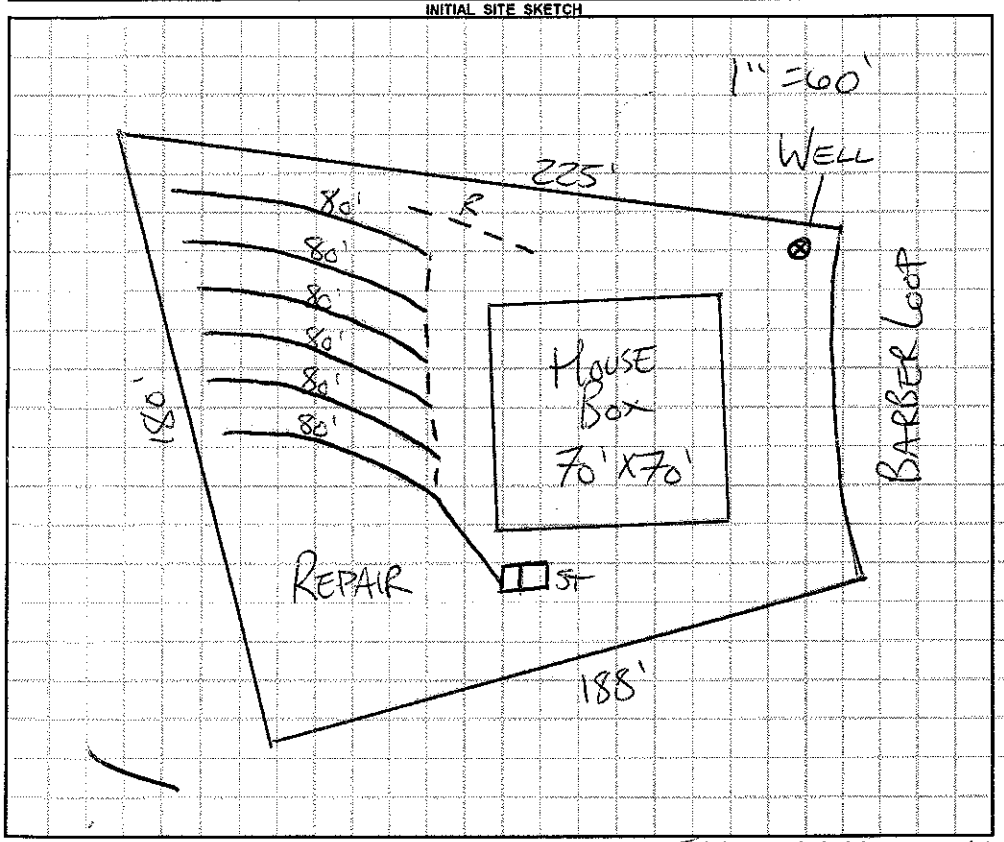

AS BUILT SKETCH

MUST BE 50' FROM ANY WELL

Permit can be suspended or revoked if any false information is supplied toward securing the permit / any unauthorized changes are made to the site / any unauthorized changes are made in the installation of the system. **CONTACT A LOCATOR SERVICE PRIOR TO ANY EXCAVATION**

☐ **IMPROVEMENT PERMIT** *with plat valid without expiration.* ☑ **IMPROVEMENT PERMIT** *with site plan valid for 60 mos.* ☐ **AUTHORIZATION TO CONSTRUCT** *valid for period equal to IMPROVEMENT PERMIT--not to exceed 60 mo.*

Owner / Applicant Signature: [signature] Date: 2-19-14 Installed by:

IMPROVEMENT PERMIT by: [signature] Date: 2-4-14 OPERATION PERMIT by: ROWAN [signature] Date: APPROVED JUN 03 2014

AUTHORIZATION TO CONSTRUCT by: [signature] Date: APPROVED FEB 24 2014 Existing System Inspected by: Date:

Health Dept. Copy - WHITE Applicant (Final Approval) - YELLOW Applicant (Conditional Approval) - PINK