IREDELL COUNTY HEALTH DEPARTMENT

STATESVILLE 704-878-5305 MOORESVILLE 704-664-5281

IMPROVEMENT PERMIT / AUTHORIZATION TO CONSTRUCT / OPERATION PERMIT / EXISTING SYSTEM INSPECTION

PERMIT # 148886 PIN # 4626101519 DATE 8/10/12

OWNER or APPLICANT LAKE LUXURY HOMES PHONE: Business Home: 704 516 2344

OWNER or APPLICANT ADDRESS PO BOX 3792 MOORESVILLE NC 28117

LOCATION / DIRECTIONS BRAWLEY SCHOOL - TR CHUCKWOOD - TL 1ST BARBER LOOP - ON RT

SUBDIVISION WATERTREE LANDING BLOCK / SECTION 4 LOT # 71 LOT AREA .69AC DESIGN FLOW 480GPD L.T.A.R. .36GPD/FT2

Septic Tank 1000 Gallons: STB 794 Date

Pump Tank Gallons: PT Date

Pump Make Model Serial #

Nitrification Field No Fields 1 No Lines 6 Linear Feet 400

Trench Width 36" Max. Trench Bottom Depth 36" Gravel Depth MA

☑ New System ☐ Repair ☐ Expansion System Type I II (III) IV V VI

System Description: GRAVITY 25% REDUCTION

Repair System Description: LP PPBPS

Maintenance Agreement Required ☐ YES ☒ NO

☑ GRAVITY ☐ PRESSURE

☑ Residence No. Bedrooms 4

☐ Business No. Persons 8

☐ Other No. Employees

☐ Slab ☑ Crawl Space


☐ Basement w/plumbing ☐ Basement w/o plumbing

Water Supply: ☑ Private ☐ Public ☐ Community

Comments / Conditions

1"= 50'

INITIAL SITE SKETCH

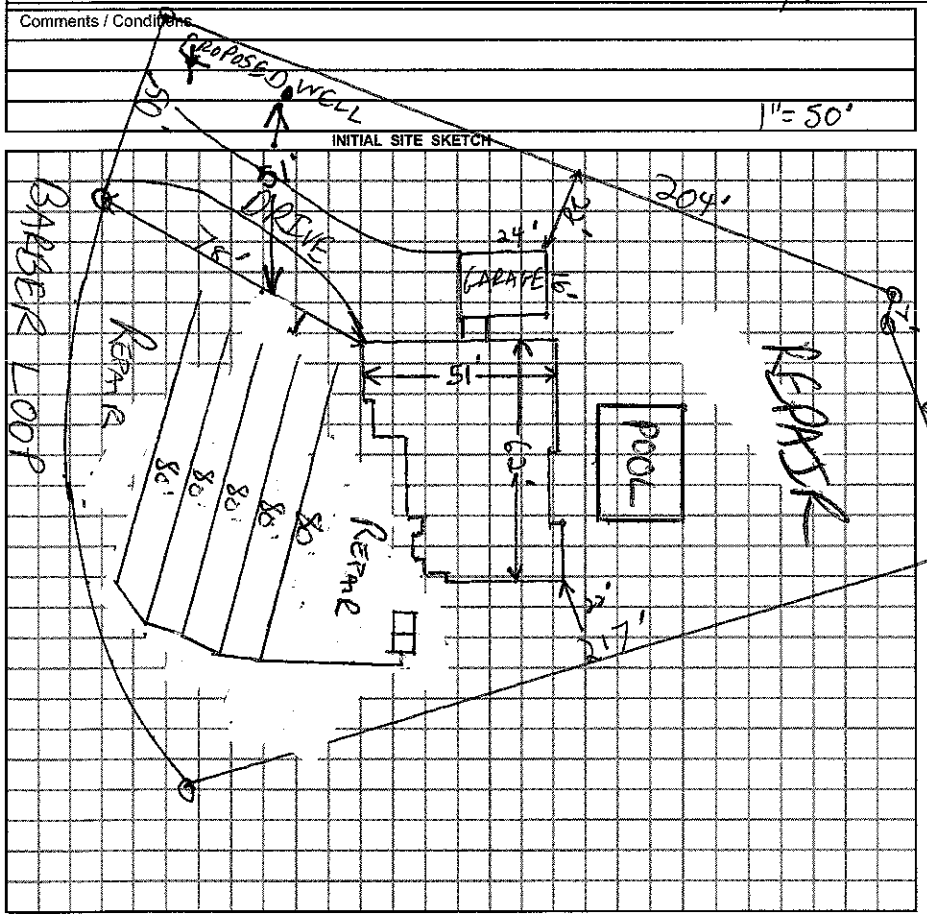

Comments / Conditions

AS BUILT SKETCH

INSTALLED 5C80' IQ4W

Permit can be suspended or revoked if any false information is supplied toward securing the permit / any unauthorized changes are made to the site / any unauthorized changes are made in the installation of the system.

☐ *IMPROVEMENT PERMIT w / plat valid without expiration.* ☑ *IMPROVEMENT PERMIT w / site plan valid for 60 mos.* ☒ *AUTHORIZATION TO CONSTRUCT valid for period equal to IMPROVEMENT PERMIT-not to exceed 60 mo.*

Owner / Applicant Signature: Date 10/9/12

Improvement Permit by: Brady Freeman RS#5 Date 8/10/12

Authorization to Construct by: Renis Date 10-9-12

Installed by: WASTEWATER SOLUTIONS

Operation Permit by: Date: 12-6-12

Existing System Inspected by: Date:

YOU SHOULD CONTACT A LOCATOR SERVICE PRIOR TO ANY EXCAVATION.

WHITE COPY Environmental Health YELLOW COPY (Final) Owner / Applicant PINK COPY (Initial) Owner / Applicant