4-18-11 Pd $180.00 PAW JM

# IREDELL COUNTY HEALTH DEPARTMENT

STATESVILLE 704-878-5305 MOORESVILLE 704-664-5281

## IMPROVEMENT PERMIT / AUTHORIZATION TO CONSTRUCT / OPERATION PERMIT / EXISTING SYSTEM INSPECTION

PERMIT # 14887 PIN # 4626-10-1945 DATE 4-15-11

OWNER or APPLICANT RICHARD PACELLA PHONE: Business 609-760-8062 Home:

OWNER or APPLICANT ADDRESS 594 BARBER LOOP MVILLE, NC 28117

LOCATION / DIRECTIONS BSR, CHUCKWOOD, TL 2ND BARBER LOOP ON L

SUBDIVISION WATERTREE LANDING BLOCK / SECTION LOT # 68 LOT AREA .71 AC DESIGN FLOW 480 L.T.A.R. .3 / .25R

Septic Tank 1000 Gallons: STB 825 Date 7-27-11
Pump Tank Gallons: P.T Date
Pump Make Model Serial #
Nitrification Field No Fields 1 No Lines 6 Linear Feet 270'
Trench Width 24-36" Max. Trench Bottom Depth 36" Gravel Depth —

☒ New System ☐ Repair ☐ Expansion System Type I II III IV V VI
System Description: G - PANEL BLOCK
Repair System Description: LP - PANEL BLOCK
Maintenance Agreement Required ☐ YES ☒ NO
☒ GRAVITY ☐ PRESSURE


☒ Residence No. Bedrooms 4
☐ Business No. Persons
☐ Other No. Employees
☐ Slab ☒ Crawl Space
☐ Basement w/plumbing ☐ Basement w/o plumbing

Water Supply
☒ Private
☐ Public
☐ Community


Comments / Conditions ① MEET ALL SETBACKS
62 PANELS

Comments / Conditions TOP 2 HAVE 11 PANELS
REST HAVE 10

INITIAL SITE SKETCH

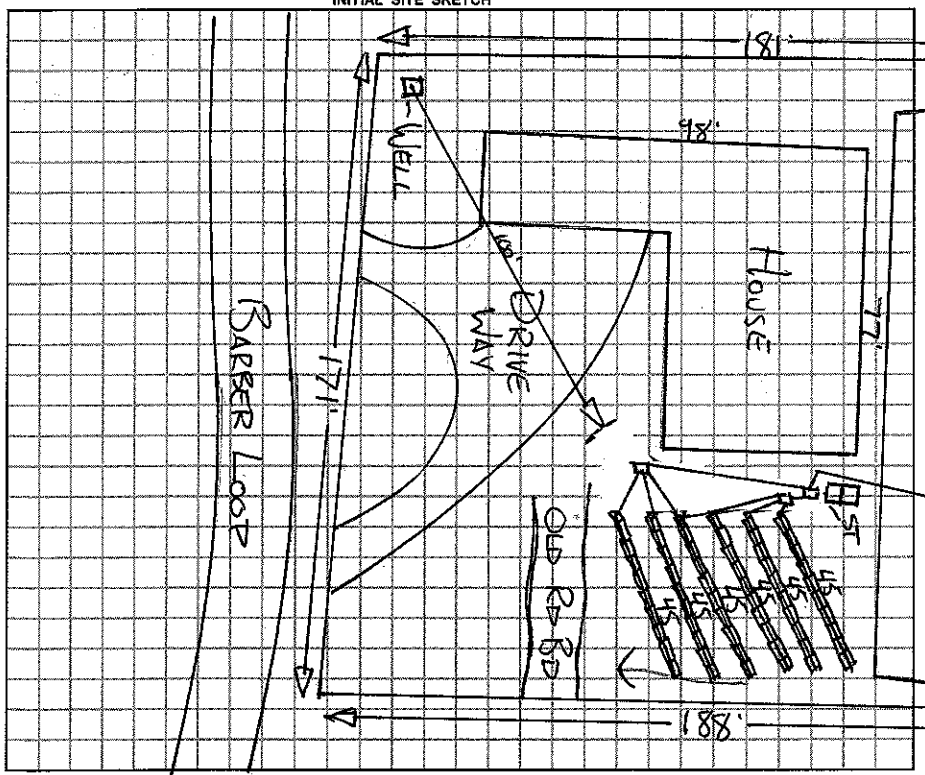


AS BUILT SKETCH

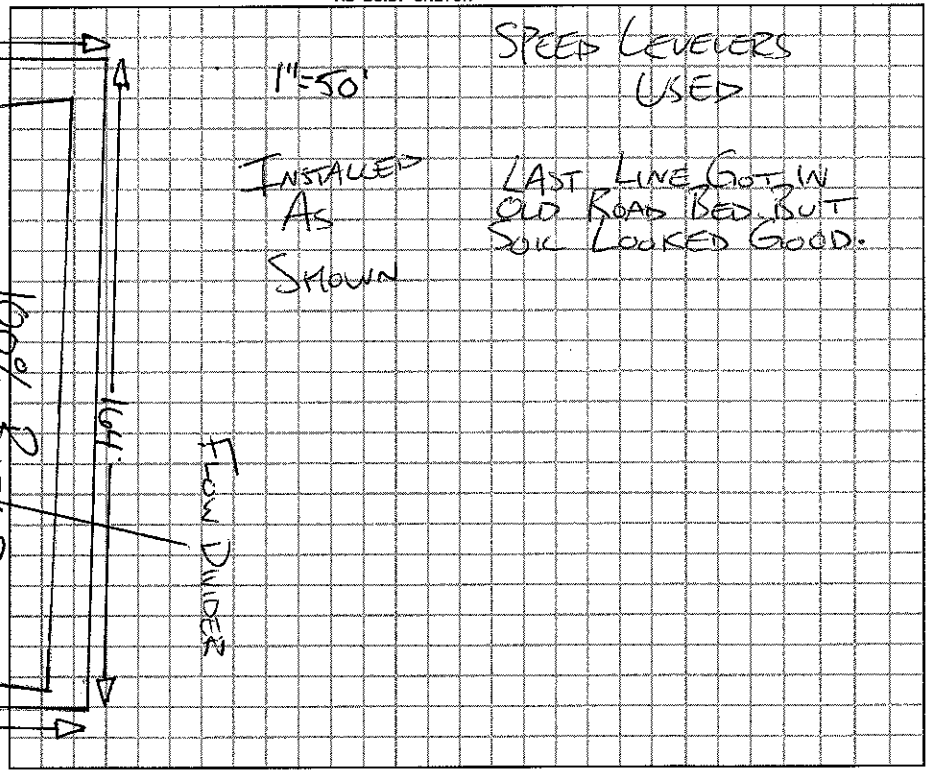


SPEED LEVELERS USED

INSTALLED AS SHOWN

LAST LINE GOT IN OLD ROAD BED, BUT SOIL LOOKED GOOD.

*Permit can be suspended or revoked if any false information is supplied toward securing the permit / any unauthorized changes are made to the site / any unauthorized changes are made in the installation of the system.*

☐ IMPROVEMENT PERMIT w / plat valid without expiration ☐ IMPROVEMENT PERMIT w / site plan valid for 60 mos. ☒ AUTHORIZATION TO CONSTRUCT valid for period equal to IMPROVEMENT PERMIT-not to exceed 60 mo.

Owner / Applicant Signature: Date 4-18-11

Improvement Permit by: REHS Date 4-15-11

Authorization to Construct by: REHS Date 4-15-11

Installed by: ROWAN SEPTIC

Operation Permit by: REHS Date: 9-2011

Existing System Inspected by: Date:

***YOU SHOULD CONTACT A LOCATOR SERVICE PRIOR TO ANY EXCAVATION.***

WHITE COPY Environmental Health YELLOW COPY (Final) Owner / Applicant PINK COPY (Initial) Owner / Applicant