IREDELL COUNTY HEALTH DEPARTMENT

Statesville Office (704) 878-5305 Mooresville Office (704) 660-3625 PERMIT # 20964G

IMPROVEMENT PERMIT / AUTHORIZATION TO CONSTRUCT / OPERATION PERMIT / EXISTING SYSTEM

PIN # 4626-10-6858.000

APPLICANT: Jeffrey Schott APPLICANT ADDRESS: 215 Barber Loop Mooresville NC

SITE ADDRESS: 215 Barber Loop Mooresville NC 28117 PHONE: 704-658-5038 ALT. PHONE:

SITE DIRECTIONS: BSR, TR Chunkwood, TL Barber Lp, Site on L

SUBDIVISION: CL&T SECTION: 7 LOT # 153 LOT AREA: — DESIGN FLOW: Existing 240 L.T.A.R.: Existing

Septic Tank Existing (gal) STB Date

Pump Tank (gal) PT Date

Pump Make Model Serial #

Nitrification Fields Ex. # Lines Ex. Bed Linear Ft: Ex

Trench Width Existing Max. Trench Bottom Depth Existing Gravel Depth Existing

☐ New System ☐ Repair ☐ Expansion System Type: ☐ II ☐ III ☐ IV ☐ V ☐ VI

System Description: Existing Bed System

Repair System Description: Repair Exempt

Maintenance Agreement Required: ☐ YES ☒ NO

☒ GRAVITY ☐ PRESSURE

☒ Residence ☐ Business ☐ Other ☐ Slab ☐ Crawl Space ☒ Basement w/plumbing ☐ Basement w/o plumbing

No. Bedrooms 2 No. Persons 4 No. Employees


Water Supply: ☒ Private ☐ Public ☐ Community

Comments / Conditions: System Appeared To Be Functioning At Time Of Inspection. Deck Addition Meets Setbacks.

INITIAL SITE SKETCH

1" = 50'

AS BUILT SKETCH

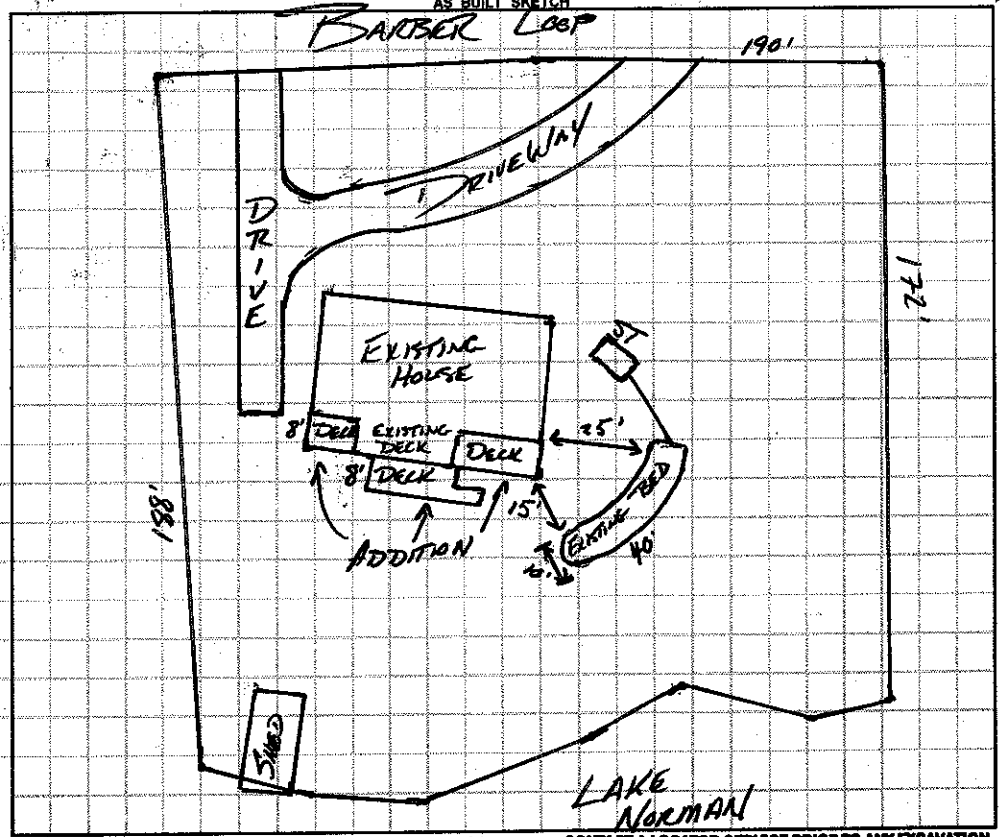

Permit can be suspended or revoked if any false information is supplied toward securing the permit / any unauthorized changes are made to the site / any unauthorized changes are made in the installation of the system. **CONTACT A LOCATOR SERVICE PRIOR TO ANY EXCAVATION**


☐ **IMPROVEMENT PERMIT** *with plat valid without expiration.* ☐ **IMPROVEMENT PERMIT** *with site plan valid for 60 mos.* ☐ **AUTHORIZATION TO CONSTRUCT** *valid for period equal to IMPROVEMENT PERMIT--not to exceed 60 mo.*

Owner / Applicant Signature: Jeffrey Schott Date: 5/12/15 Installed by:

IMPROVEMENT PERMIT by: Date: OPERATION PERMIT by: Date:

AUTHORIZATION TO CONSTRUCT by: Date: Existing System Inspected by: Date: APPROVED MAY 08 2015

Health Dept. Copy - WHITE Applicant (Final Approval) - YELLOW Applicant (Conditional Approval) - PINK

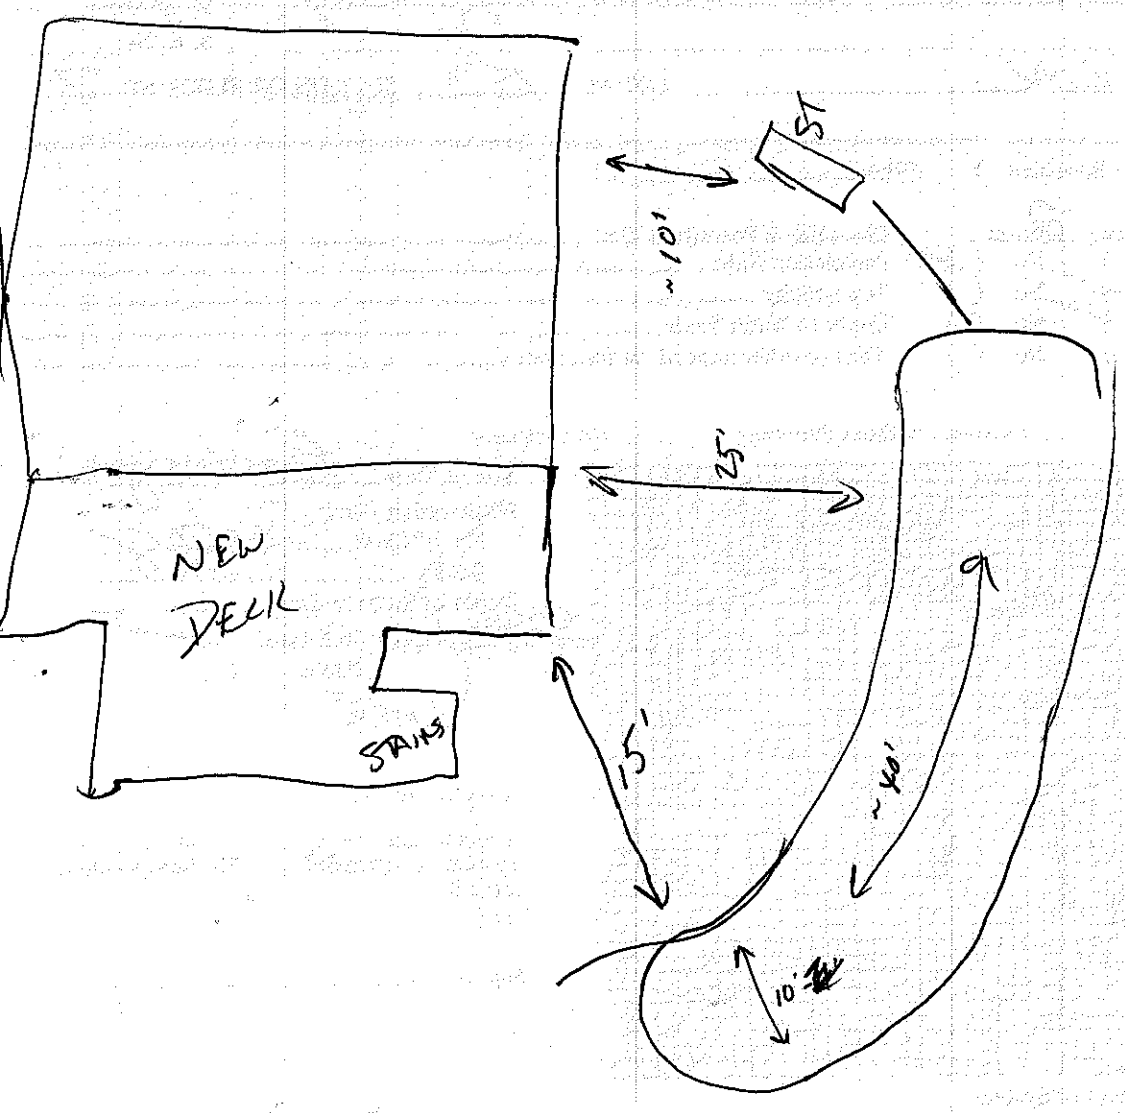
ST
~10'
25'
NEW
DECK
STAIRS
15'
~40'
10'