IREDELL COUNTY HEALTH DEPARTMENT

STATESVILLE 704-878-5305 — MOORESVILLE 704-664-5281

IMPROVEMENT PERMIT / AUTHORIZATION TO CONSTRUCT / OPERATION PERMIT / EXISTING SYSTEM INSPECTION

PERMIT# 116366 PIN# 4626 11 2411 DATE 10/27/03

OWNER OR CONTRACTOR Steve Ebert PHONE: Business 704-562-0638 Home

ADDRESS 621 Barber Loop Mooresville, NC. 28117

LOCATION 1100, TR Chinkwood to end TL on Barber Loop TR first driveway

SUBDIVISION C L + T BLOCK / SECTION 7 LOT 62 LOT AREA SITE CLASS. DESIGN FLOW 240 L.T.A.R.

Septic Tank: EXISTING Gallons; STB Date

Pump Tank: Gallons; PT Date

Pump Make: Model Serial No.

Nitrification Field: No Fields Square Feet EXISTING SYSTEM

No Lines Trench Width Max Trench Bottom Depth Gravel Depth

☐ New System ☐ Repair System Type: I, (II), III, IV, V, VI

System Description: EXISTING SYSTEM - BED.

Repair System Description:

Maintenance Agreement Required: ☐ Yes ☐ No

☒ House/Mod. Home No. Bedrooms 2

☒ Mobile Home No. Bathrooms 2.5

☐ Business No. Employees

☐ Other

☐ Slab ☐ Crawl Space ☐ Basement w/plumbing ☐ Basement w/o plumbing


Water Supply:
☒ Individual
☐ Public
☐ Community

Comments:/Conditions:

INITIAL SITE SKETCH

Comments:/Conditions:

AS BUILT SKETCH

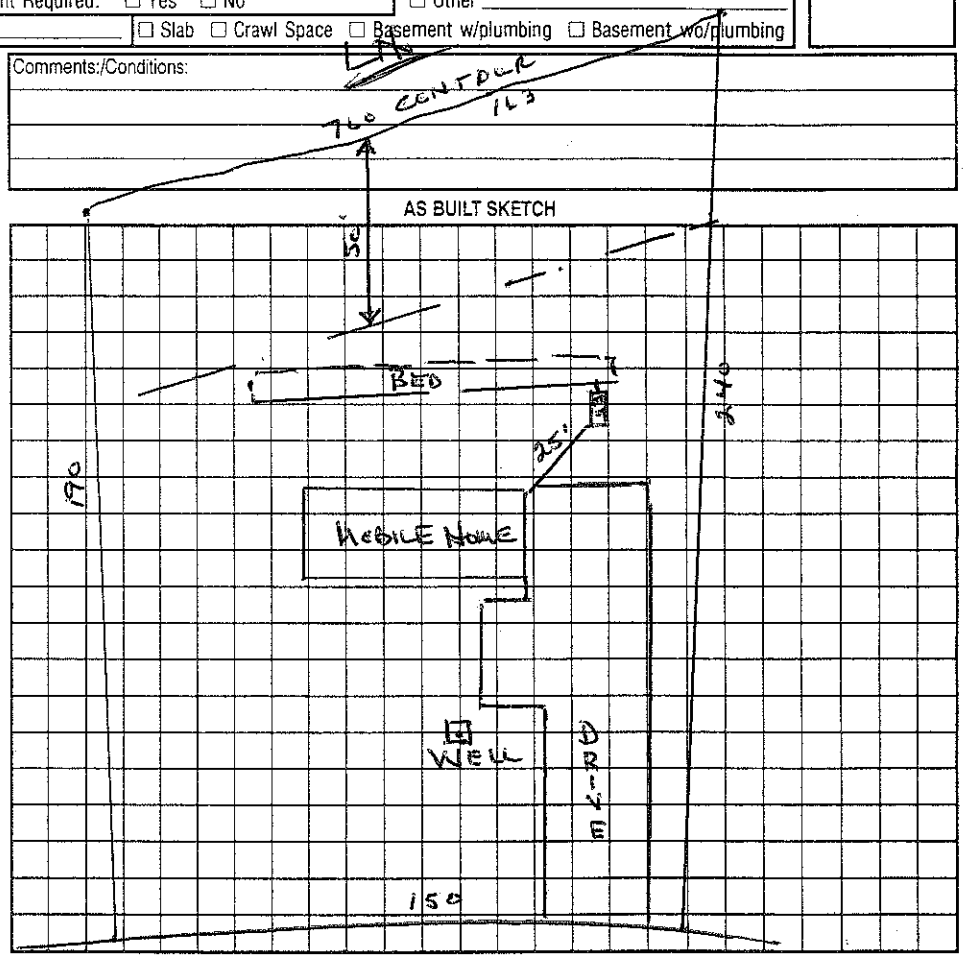

Permit can be suspended or revoked if any false information is supplied toward securing the permit/any unauthorized changes are made to the site/any unauthorized changes are made in the installation of the system. Improvement Permit with plat valid without expiration. Improvement Permit with site plan valid for sixty months. Authorization to Construct is valid for a period equal to that of Improvement Permit -- not to exceed sixty months.

Signed: X Steve Ebert date 10-28-03 Installed by:

Improvement Permit by: date Operation Permit by: date

Authorization to Construct by: date Existing System Inspection by: Wesley Sparks RS. date 10/27/03

HEALTH DEPT. COPY: WHITE OWNER COPY (FINAL): YELLOW OWNER COPY (INITIAL): PINK