4,000

IREDELL COUNTY HEALTH DEPARTMENT

Statesville Office (704) 878-5305 Mooresville Office (704) 660-3625 PERMIT # 17621

IMPROVEMENT PERMIT / AUTHORIZATION TO CONSTRUCT / OPERATION PERMIT / EXISTING SYSTEM

PIN # 4626143376

APPLICANT: LAKE LUXURY HOMES APPLICANT ADDRESS: PO BOX 3792 MOORESVILLE, NC 28117

SITE ADDRESS: 409 CHUCKWOOD RD - MOORESVILLE PHONE: ALT. PHONE:

SITE DIRECTIONS: BRAWLEY SCHOOL - TL CHUCKWOOD - ON LEFT AT END

SUBDIVISION: WATERTREE LANDING SECTION: LOT # 86 LOT AREA: .72AC DESIGN FLOW: 480GPD L.T.A.R.: .275GPD/FT.

Septic Tank 1000 (gal) STB 799 Date 3-17-13
Pump Tank (gal) PT Date
Pump Make Model Serial #
Nitrification Fields 1 # Lines 6 Linear Ft: 435
Trench Width 36" Max. Trench Bottom Depth 36" Gravel Depth N/A


☑ New System ☐ Repair ☐ Expansion System Type: I II ☑ III IV V VI
System Description: GRAVITY 25% REDUCTION
Repair System Description: LP PIPES
Maintenance Agreement Required: ☐ YES ☑ NO
☑ GRAVITY ☐ PRESSURE

☑ Residence No. Bedrooms 4
☐ Business No. Persons 8
☐ Other No. Employees
☐ Slab ☑ Crawl Space
☐ Basement w/plumbing ☐ Basement w/o plumbing

Water Supply: ☑ Private ☐ Public ☐ Community

Comments / Conditions:

INITIAL SITE SKETCH

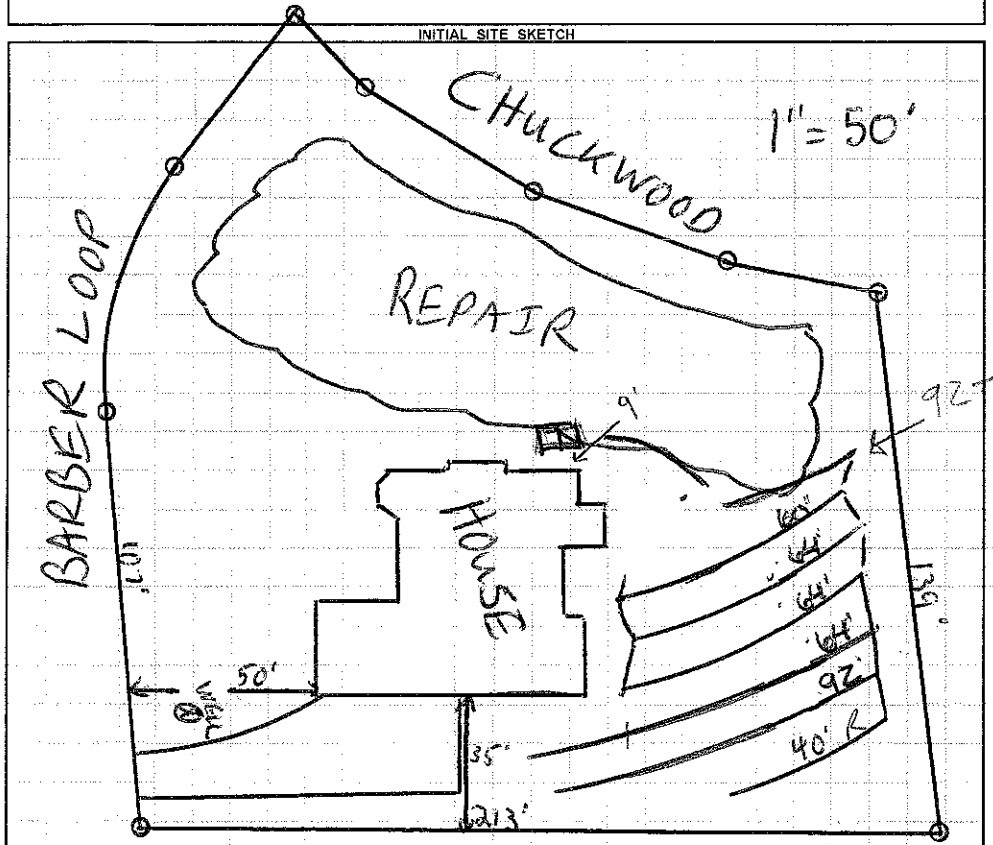

AS BUILT SKETCH

Permit can be suspended or revoked if any false information is supplied toward securing the permit / any unauthorized changes are made to the site / any unauthorized changes are made in the installation of the system. **CONTACT A LOCATOR SERVICE PRIOR TO ANY EXCAVATION**

☐ **IMPROVEMENT PERMIT** *with plat valid without expiration.* ☑ **IMPROVEMENT PERMIT** *with site plan valid for 60 mos.* ☑ **AUTHORIZATION TO CONSTRUCT** *valid for period equal to IMPROVEMENT PERMIT--not to exceed 60 mo.*

Owner / Applicant Signature: Date: 1/3/13 Installed by: RUSSELL WILLIAMS

IMPROVEMENT PERMIT by: C. Brady Thompson REHS Date: 1/3/12 OPERATION PERMIT by: Date: 4-25-13

AUTHORIZATION TO CONSTRUCT by: C. Brady Thompson REHS Date: 1/3/12 Existing System Inspected by: Date:

Health Dept. Copy - WHITE Applicant (Final Approval) - YELLOW Applicant (Conditional Approval) - PINK