IREDELL COUNTY HEALTH DEPARTMENT

Statesville Office (704) 878-5305 Mooresville Office (704) 660-3625 PERMIT # DF 176215

IMPROVEMENT PERMIT / AUTHORIZATION TO CONSTRUCT / OPERATION PERMIT / EXISTING SYSTEM

PIN # 4626-11-6371

APPLICANT: LAKE LUXURY HOMES APPLICANT ADDRESS: PO BOX 3792 MVILLE

SITE ADDRESS: 401 CHUCKWOOD RD PHONE: 704-510-2344 ALT. PHONE:

SITE DIRECTIONS: BSR, CHUCKWOOD, ON L

SUBDIVISION: WATERTREE LANDING SECTION: LOT # 87 LOT AREA: .8 AC DESIGN FLOW: 600 L.T.A.R.: .3

Septic Tank 1500 (gal) STB 1014 Date 1-3-14
Pump Tank (gal) PT Date
Pump Make Model Serial #
Nitrification Fields 1 # Lines 6 Linear Ft: 500'
Trench Width 36" Max. Trench Bottom Depth 36" Gravel Depth —


☒ New System ☐ Repair ☐ Expansion System Type: I II (III) IV V VI
System Description: 25% REDUCTION
Repair System Description: LP PANEL BLOCK
Maintenance Agreement Required: ☐ YES ☒ NO
☒ GRAVITY ☐ PRESSURE

☒ Residence No. Bedrooms 5
☐ Business No. Persons
☐ Other No. Employees
☐ Slab ☒ Crawl Space
☐ Basement w/plumbing ☐ Basement w/o plumbing


Water Supply: ☒ Private ☐ Public ☐ Community

Comments / Conditions:

INITIAL SITE SKETCH

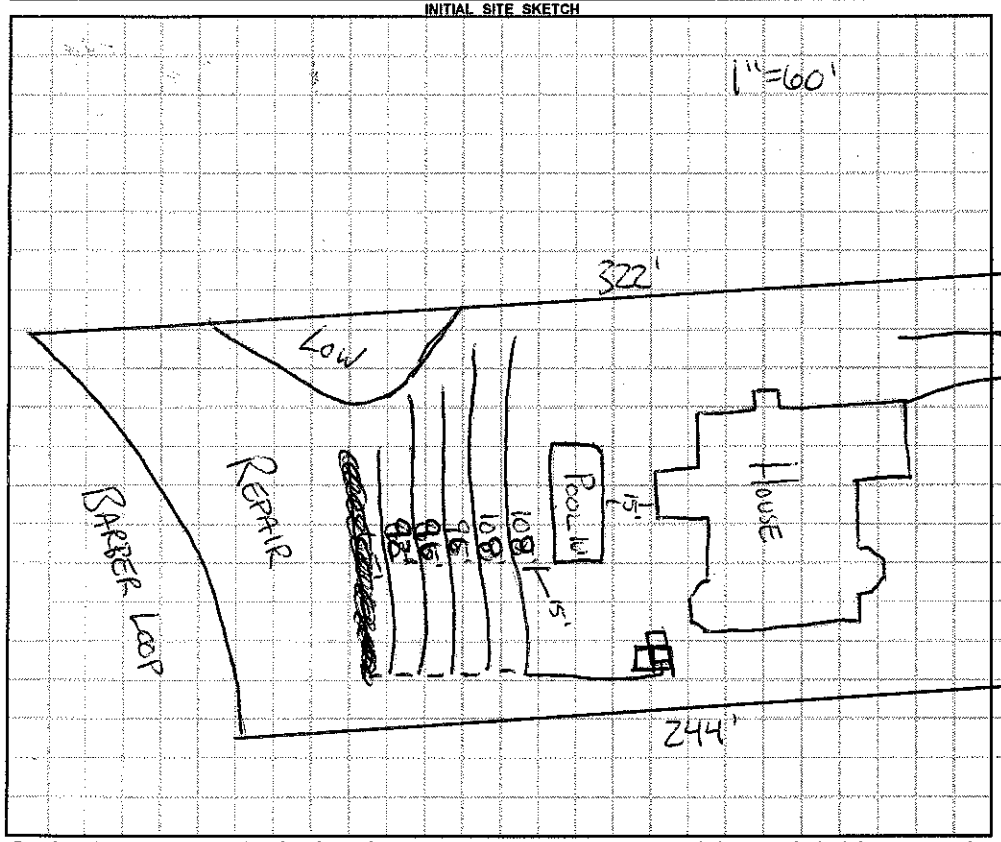

AS BUILT SKETCH

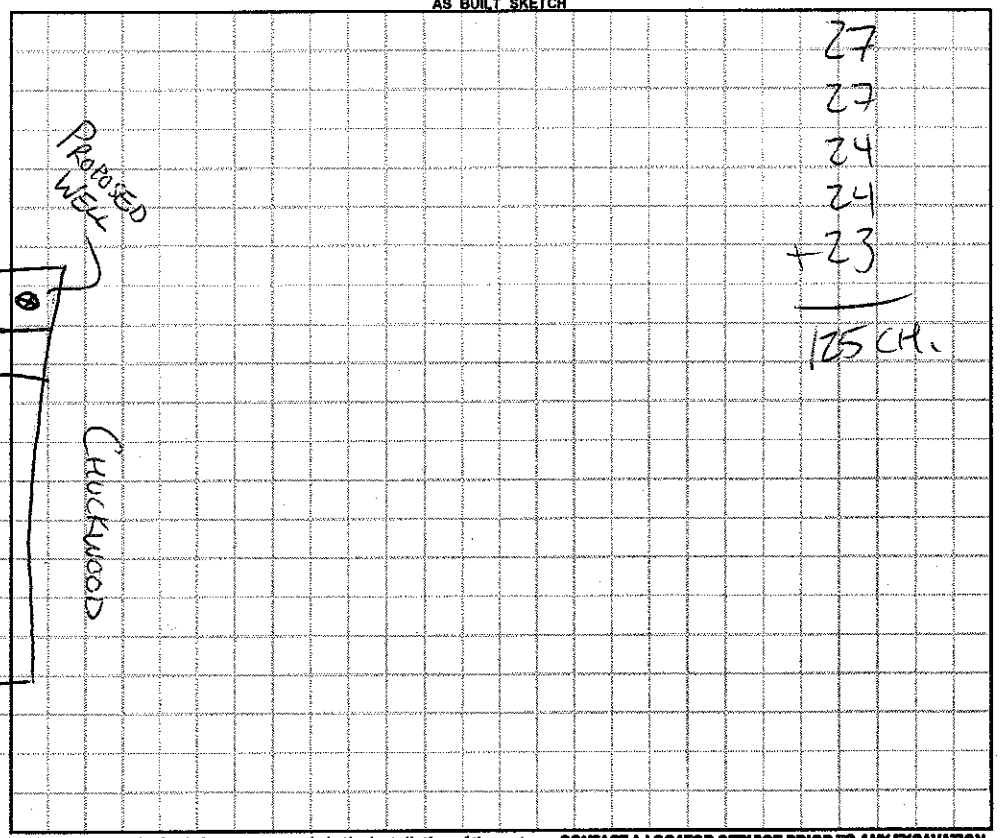

Permit can be suspended or revoked if any false information is supplied toward securing the permit / any unauthorized changes are made to the site / any unauthorized changes are made in the installation of the system. **CONTACT A LOCATOR SERVICE PRIOR TO ANY EXCAVATION**

☐ **IMPROVEMENT PERMIT** *with plat valid without expiration.* ☒ **IMPROVEMENT PERMIT** *with site plan valid for 60 mos.* ☐ **AUTHORIZATION TO CONSTRUCT** *valid for period equal to IMPROVEMENT PERMIT--not to exceed 60 mo.*

Owner / Applicant Signature: Date: 2-9-14 Installed by: ROWAN

IMPROVEMENT PERMIT by: Date: 2-4-14 OPERATION PERMIT by: APPROVED Date: MAR 14 2014

AUTHORIZATION TO CONSTRUCT by: APPROVED FEB 20 2014 Existing System Inspected by: Date:

Health Dept. Copy - WHITE Applicant (Final Approval) - YELLOW Applicant (Conditional Approval) - PINK