IREDELL COUNTY HEALTH DEPARTMENT

STATESVILLE 704-878-5305 MOORESVILLE 704-664-5281

IMPROVEMENT PERMIT / AUTHORIZATION TO CONSTRUCT / OPERATION PERMIT / EXISTING SYSTEM INSPECTION

PERMIT# 24573 PIN# 2F-1-56 4626 117748 DATE 1/20/98

OWNER OR CONTRACTOR Joe Dellinger PHONE: Business Home 664-6209

ADDRESS 117 Indian Trail Rd. Mooresville, NC. 28115

LOCATION Chuckwood Rd. TR on Indian Trail to 4th lot on left.

SUBDIVISION CL+T BLOCK / SECTION 7 LOT 56 LOT AREA Existing SITE CLASS: PS DESIGN FLOW 360 L.T.A.R. .3

Septic Tank: Existing Gallons; STB Date

Pump Tank: Gallons; PT Date

Pump Make: Model Serial No.

Nitrification Field: No Fields Square Feet Existing ~~Linear Feet~~

No Lines Trench Width Max Trench Bottom Depth Gravel Depth

[X] New System [ ] Repair System Type: I, II, (III), IV, V, VI

System Description: Adding Grinder Pump

Repair System Description:

Maintenance Agreement Required: [ ] Yes [X] No

[X] House/Mod. Home No. Bedrooms 3

[ ] Mobile Home No. Bathrooms 2

[ ] Business No. Employees

[ ] Other

[ ] Slab [ ] Crawl Space [ ] Basement w/plumbing [ ] Basement wo/plumbing


Water Supply: [X] Individual [ ] Public [ ] Community

Comments:/Conditions: LN


Comments:/Conditions: MBL Home must be removed!!

Grinder Pump must be inspected by HD. before Oper Permit can be issued.

INITIAL SITE SKETCH

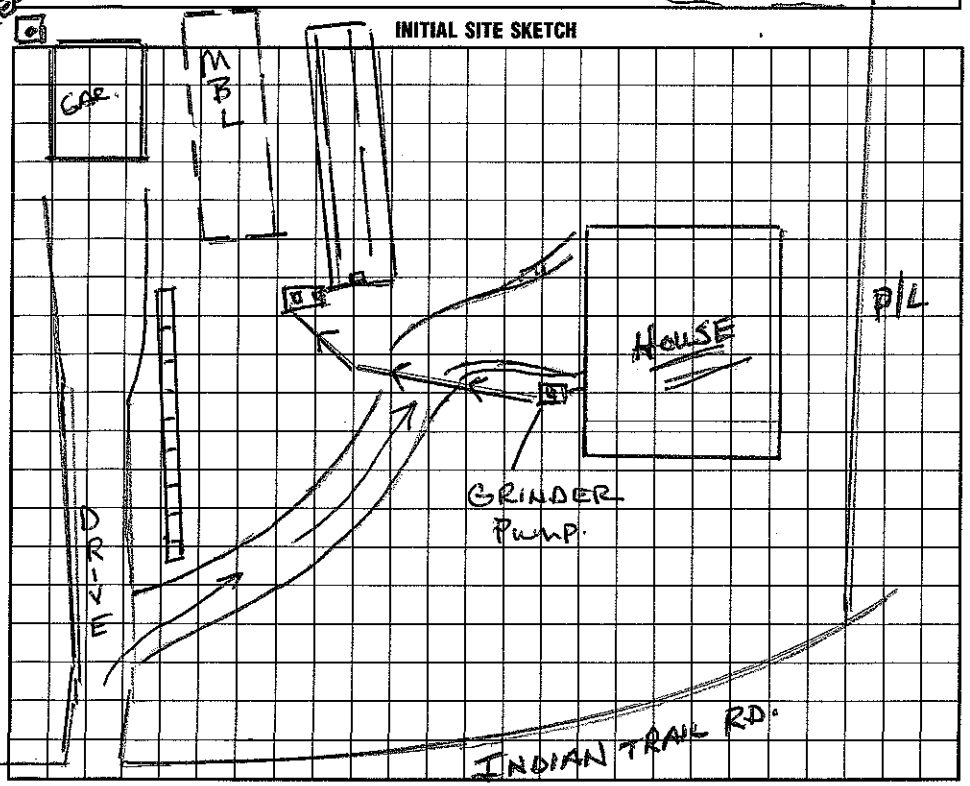

AS BUILT SKETCH

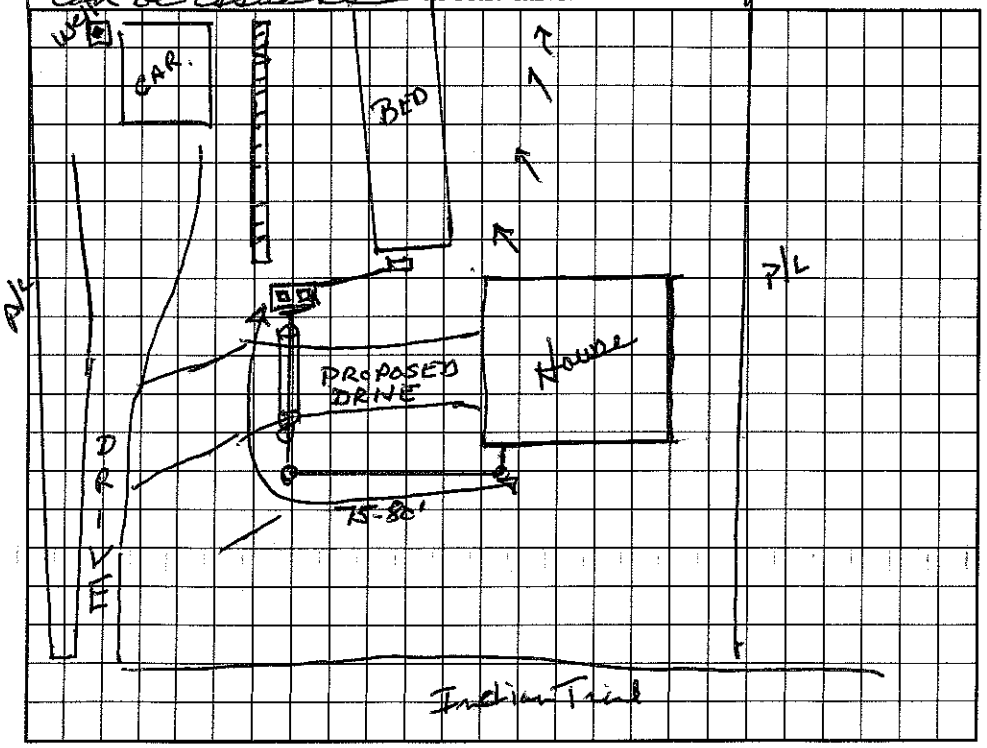

I understand that this permit can be suspended or revoked if any false information is supplied toward securing the permit/any unauthorized changes are made to the site/any unauthorized changes are made in the installation of the system. Improvement Permit with plat valid without expiration. Improvement Permit with site plan valid for sixty months. Authorization to Construct is valid for a period equal to that of Improvement Permit – not to exceed sixty months.

Signed: Allen Beck date 1-21-98

Improvement Permit by: Wesley Sparks RS. date 1/20/98

Authorization to Construct by: Wesley Sparks RS. date 1/20/98

Installed by: Larry Beam

Operation Permit by: Wesley Sparks RS. date 7/9/98

Existing System Inspection by: Wesley Sparks date 7/9/98

HEALTH DEPT. COPY: WHITE INSPECTION COPY (FINAL): GREEN OWNER COPY (FINAL): YELLOW INSPECTION COPY (INITIAL): PINK OWNER COPY (INITIAL): GOLD