IREDELL COUNTY HEALTH DEPARTMENT

STATESVILLE 704-878-5305 MOORESVILLE 704-664-5281

IMPROVEMENT PERMIT / AUTHORIZATION TO CONSTRUCT / OPERATION PERMIT / EXISTING SYSTEM INSPECTION

PERMIT# 134711 PIN# 4626129604 Tim Kiker DATE 10-15-07

OWNER OR APPLICANT Kenneth Bealer Homes PHONE: Business 704 746-4669 Home 6662-6400

ADDRESS 177 Indian Trail 1454 Brawley School Rd Mooresville, NC 28117

LOCATION Brawley School Rd TR, Chuckwood TR Indian Trail on left after Chaco Ln.

SUBDIVISION Clay T BLOCK / SECTION 1 LOT 46 LOT AREA .87 Acre SITE CLASS. PS DESIGN FLOW 480gpd L.T.A.R. —

EXIST

Septic Tank: 1500 Gallons: STB — Date —

Pump Tank: — Gallons: PT — Date —

Pump Make: — Model — Serial No. —

Nitrification Field: No Fields 1 Square Feet 900' Linear Feet 300'

No Lines 3@100' Trench Width 36" Max Trench Bottom Depth — Gravel Depth 10"

☐ New System ☐ Repair ☐ Expansion System Type: I II III IV V VI

System Description: 2 Lines @ Gravity - Conventional

Repair System Description: Pump-25-50% Reduct.

Maintenance Agreement Required: ☐ Yes ☒ No

☒ Gravity ☐ Pressure

☒ House/Mod. Home No. Bedrooms 4

☐ Mobile Home No. Persons —

☐ Business No. Employees —

☐ Other —


Water Supply: ☒ Individual ☐ Public ☐ Community

☐ Slab ☐ Crawl Space ☒ Basement w/plumbing ☐ Basement wo/plumbing


Comments:/Conditions: Old well must be "properly abandoned" Keep New well at least 50ft From Septic System. Keep house at least 5Ft From Septic

Comments:/Conditions: Septic System originally permitted for 4 Bdrms in 1978.

INITIAL SITE SKETCH Scale 1:50

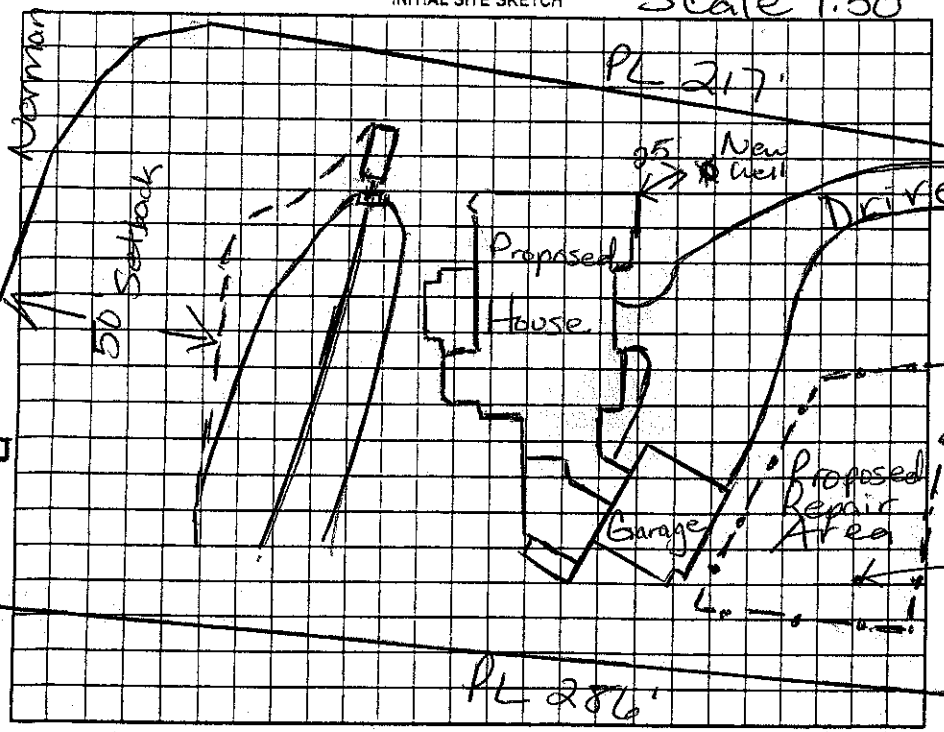

AS BUILT SKETCH

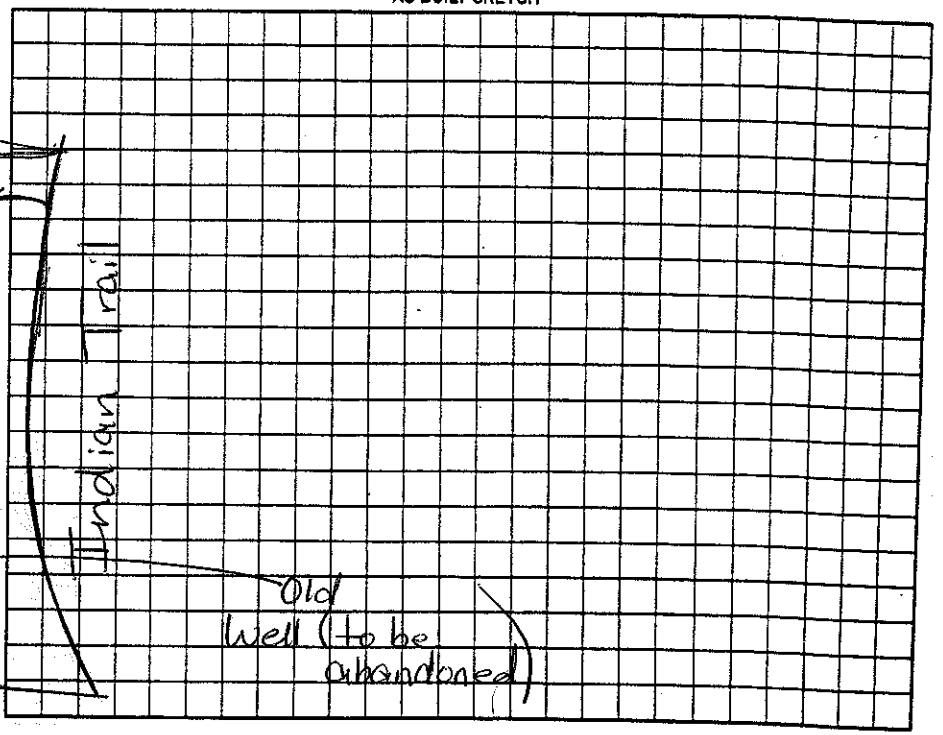

Permit can be suspended or revoked if any false information is supplied toward securing the permit/any unauthorized changes are made to the site/any unauthorized changes are made in the installation of the system. Improvement Permit with plat valid without expiration ☐ Improvement Permit with site plan valid for sixty months ☐ Authorization to Construct is valid for a period equal to that of Improvement Permit – not to exceed sixty months.

Signed: Cathy C Lee date 10-17-07 Installed by: —

Improvement Permit by: Maria H Bealer RS date 10/15/07 Operation Permit by: — date —

Authorization to Construct by: Maria H Bealer RS date 10/15/07 Existing System Inspection by: Maria H Bealer RS date 10/15/07

HEALTH DEPT. COPY: WHITE OWNER COPY (FINAL): YELLOW OWNER COPY (INITIAL): PINK