IREDELL COUNTY HEALTH DEPARTMENT

STATESVILLE 704-878-5305 MOORESVILLE 704-664-5281

IMPROVEMENT PERMIT / AUTHORIZATION TO CONSTRUCT / OPERATION PERMIT / EXISTING SYSTEM INSPECTION

PERMIT# 13471 PIN# 4626-12-9609 DATE 5/3/06

OWNER OR APPLICANT ART Goast PHONE: Business 704-664-4353 Home

ADDRESS 1189 Brawley School Rd Mooresville NC 28117

LOCATION BSR TR Chuckwood, TR Indian Trail, on Lt past Chaco Ln # 177 Indian Trail

SUBDIVISION CL+F BLOCK / SECTION 4 LOT 46 LOT AREA 0.871c SITE CLASS. PS DESIGN FLOW 480 L.T.A.R.

Septic Tank: Exist/1500 Gallons; STB Date

Pump Tank: Gallons; PT Date

Pump Make: Model Serial No.

Nitrification Field: No Fields Square Feet 900 Linear Feet 300

No Lines ? Trench Width Max Trench Bottom Depth Gravel Depth 10" ☐ Gravity ☐ Pressure

☐ New System ☐ Repair ☐ Expansion System Type: I II III IV V VI

System Description: Exist. Conventional

Repair System Description:

Maintenance Agreement Required: ☐ Yes ☐ No

☒ House/Mod. Home No. Bedrooms 4*

☐ Mobile Home No. Persons

☐ Business No. Employees

☐ Other

Water Supply: ☒ Individual ☐ Public ☐ Community


☐ Slab ☐ Crawl Space ☐ Basement w/plumbing ☐ Basement wo/plumbing

Comments:/Conditions:


1"=40'

Comments:/Conditions: * House will be a 3 bedroom - System originally installed for 4 bedroom

INITIAL SITE SKETCH

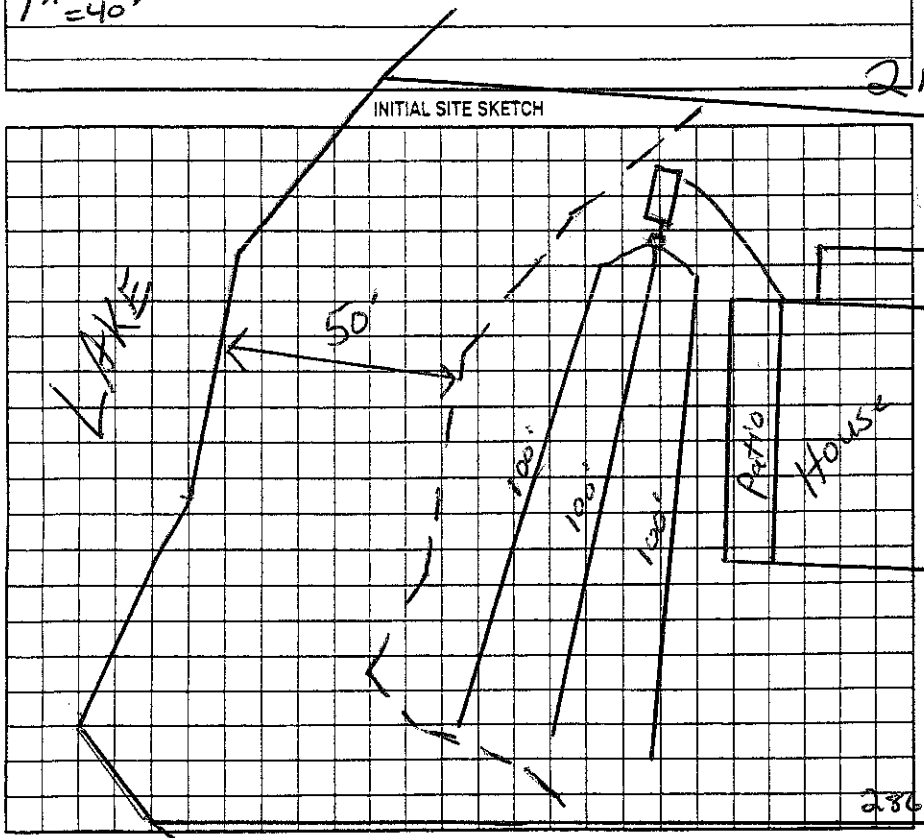

AS BUILT SKETCH

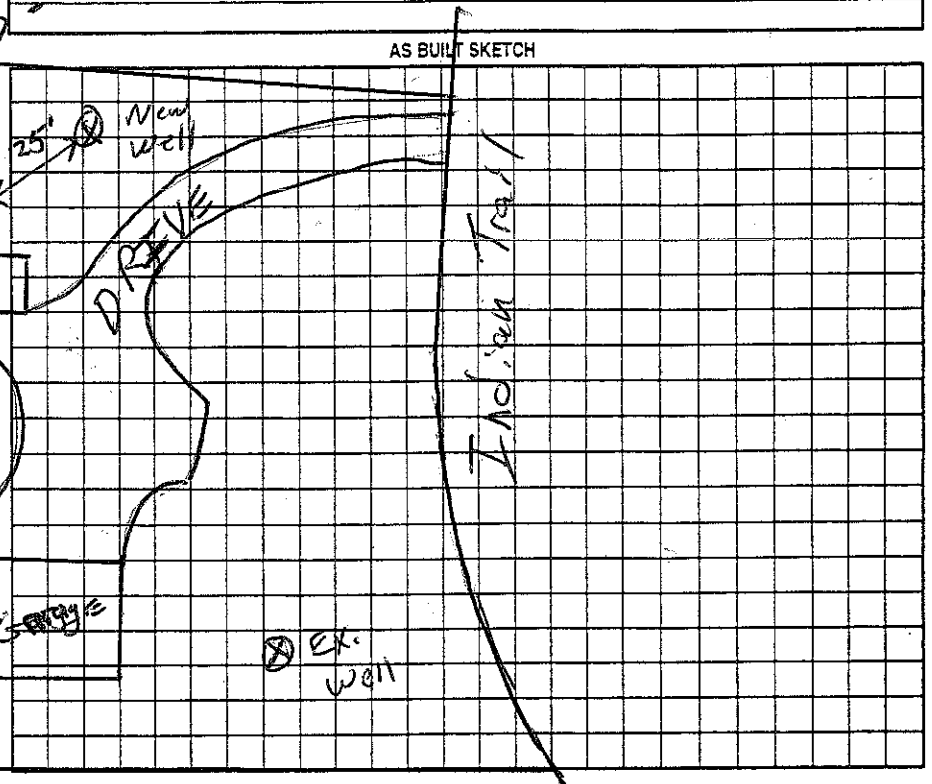

Permit can be suspended or revoked if any false information is supplied toward securing the permit/any unauthorized changes are made to the site/any unauthorized changes are made in the installation of the system. Improvement Permit with plat valid without expiration. ☐ Improvement Permit with site plan valid for sixty months ☑ Authorization to Construct is valid for a period equal to that of Improvement Permit – not to exceed sixty months.

Signed: Jerry McMinn date 5/4/06 Installed by:

Improvement Permit by: date Operation Permit by: date

Authorization to Construct by: date Existing System Inspection by: RS date 5/3/06

HEALTH DEPT. COPY: WHITE OWNER COPY (FINAL): YELLOW OWNER COPY (INITIAL): PINK