IREDELL COUNTY HEALTH DEPARTMENT

STATESVILLE 704-878-5305 MOORESVILLE 704-664-5281

IMPROVEMENT PERMIT / AUTHORIZATION TO CONSTRUCT / OPERATION PERMIT / EXISTING SYSTEM INSPECTION

PERMIT# Repair PIN# 4626130924 DATE 8/2/05

OWNER OR CONTRACTOR William G. Morris PHONE: Business Home 704 664-6302

ADDRESS 893 Kemp Rd Mooresville NC 28117

LOCATION BSR TR McKendree to End, TL Kemp, on Rt #893 Kemp

SUBDIVISION CLT BLOCK / SECTION 8 LOT 19.5 LOT AREA 0.93Ac SITE CLASS. PS DESIGN FLOW 240 L.T.A.R. —

Septic Tank: 1000 Gallons; STB 312 Date 12/23/05

Pump Tank: Gallons; PT Date

Pump Make: Model Serial No.

Nitrification Field: No Fields 1 Square Feet 720 Linear Feet 240

No Lines 3@50' Trench Width 36" Max Trench Bottom Depth 36" Gravel Depth 12"

~~New System~~ ☒ Repair System Type: I (II) III, IV, V, VI

~~Septic~~ Description: Gravity Conventional

Repair System Description:

Maintenance Agreement Required: ☐ Yes ☒ No

☒ House/Mod. Home No. Bedrooms 2

☐ Mobile Home No. Bathrooms

☐ Business No. Employees

☐ Other


☐ Slab ☒ Crawl Space ☐ Basement w/plumbing ☐ Basement wo/plumbing

Water Supply: ☒ Individual ☐ Public ☐ Community


Comments:/Conditions:

Comments:/Conditions: Hydrotherm installed installed as drawn

INITIAL SITE SKETCH

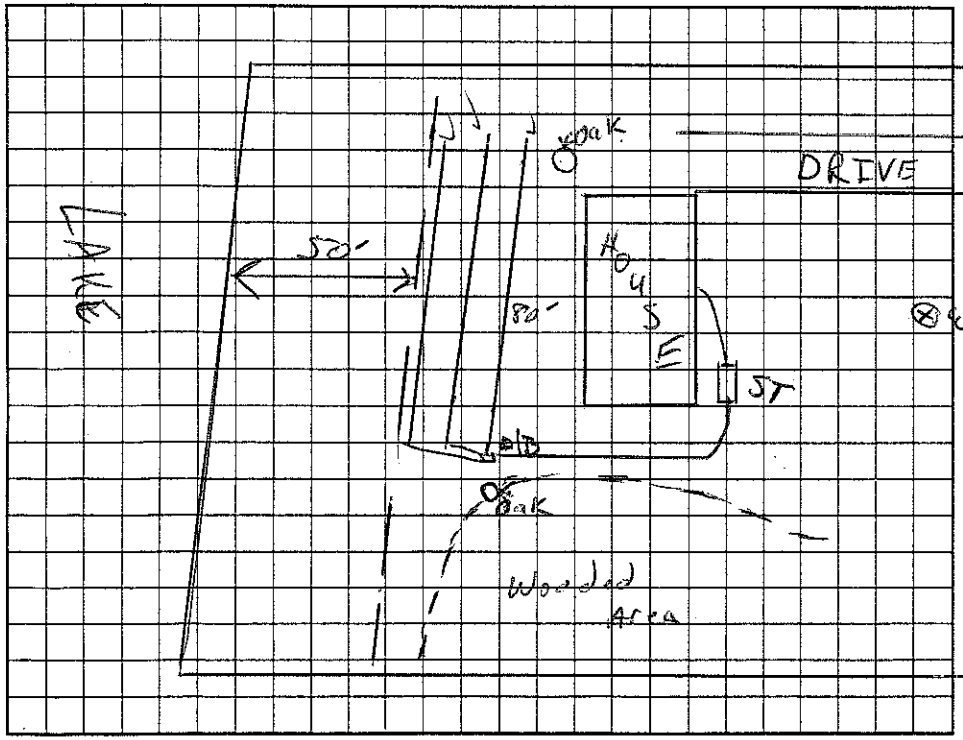

AS BUILT SKETCH

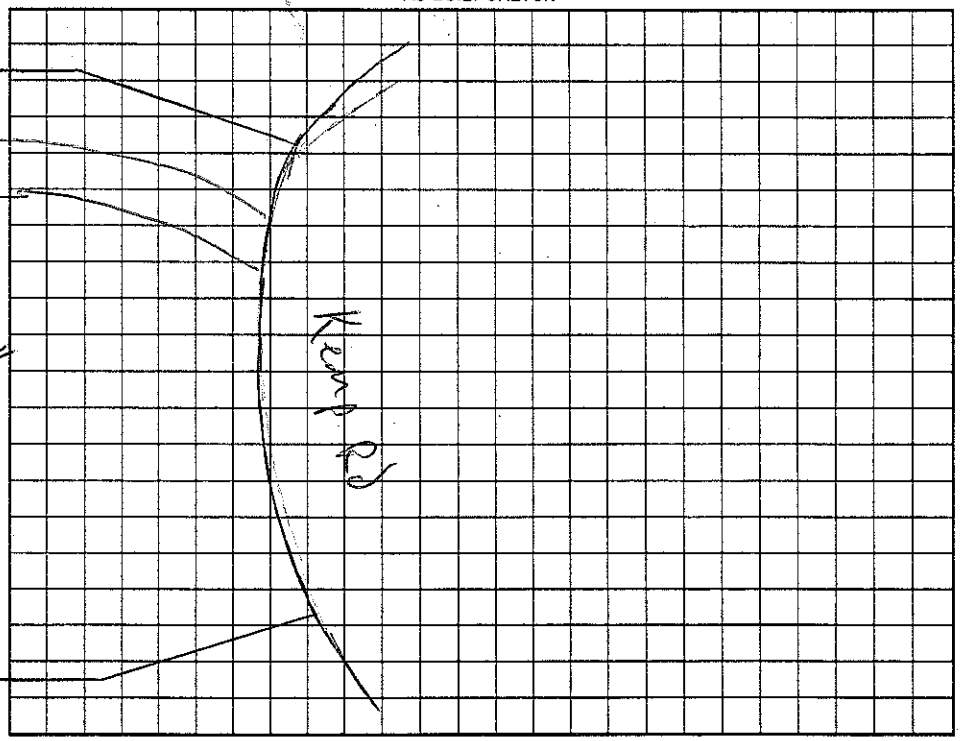

Permit can be suspended or revoked if any false information is supplied toward securing the permit/any unauthorized changes are made to the site/any unauthorized changes are made in the installation of the system. Improvement Permit with plat valid without expiration. Improvement Permit with site plan valid for sixty months. Authorization to Construct is valid for a period equal to that of Improvement Permit – not to exceed sixty months.

Signed: William G. Morris Jr. date 8-24-05 Installed by: F J Hamrick

Improvement Permit by: RS date 8/2/05 Operation Permit by: Wesley Sprinkle RS date 4/6/06

Authorization to Construct by: RS date 8/2/05 Existing System Inspection by: date

HEALTH DEPT. COPY: WHITE OWNER COPY (FINAL): YELLOW OWNER COPY (INITIAL): PINK