IREDELL COUNTY HEALTH DEPARTMENT

STATESVILLE 704-878-5305 MOORESVILLE 704-664-5281

IMPROVEMENT PERMIT / AUTHORIZATION TO CONSTRUCT / OPERATION PERMIT / EXISTING SYSTEM INSPECTION

PERMIT # 159395 PIN # 4626-15-9907 DATE 12-31-09

OWNER or APPLICANT CHARLES WATTS PHONE: Business 704-372-2340 Home:

OWNER or APPLICANT ADDRESS 1530 QUEENS RD CHARLOTTE, NC 28207

LOCATION / DIRECTIONS BSR, TR MCKENDREE, TL KEMP, 433

SUBDIVISION CL&T BLOCK / SECTION 8 LOT # 139 LOT AREA 1.16AC DESIGN FLOW 360 GPD L.T.A.R.

Septic Tank Gallons: STB Date

Pump Tank Gallons: PT Date

Pump Make EXISTING Model Serial #

Nitrification Field No Fields No Lines Linear Feet

Trench Width Max. Trench Bottom Depth Gravel Depth

☐ New System ☐ Repair ☐ Expansion System Type I II III IV V VI

System Description:

Repair System Description: EXISTING

Maintenance Agreement Required ☐ YES ☐ NO

☒ GRAVITY ☐ PRESSURE

☒ Residence No. Bedrooms 3

☐ Business No. Persons

☐ Other No. Employees

☐ Slab ☒ Crawl Space


☐ Basement w/plumbing ☐ Basement w/o plumbing

Water Supply: ☒ Private ☐ Public ☐ Community


Comments / Conditions
1) DECK MUST BE 5' FROM SEPTIC
2) SYSTEM WORKING FINE @ TIME OF INSPECTION

Comments / Conditions

INITIAL SITE SKETCH

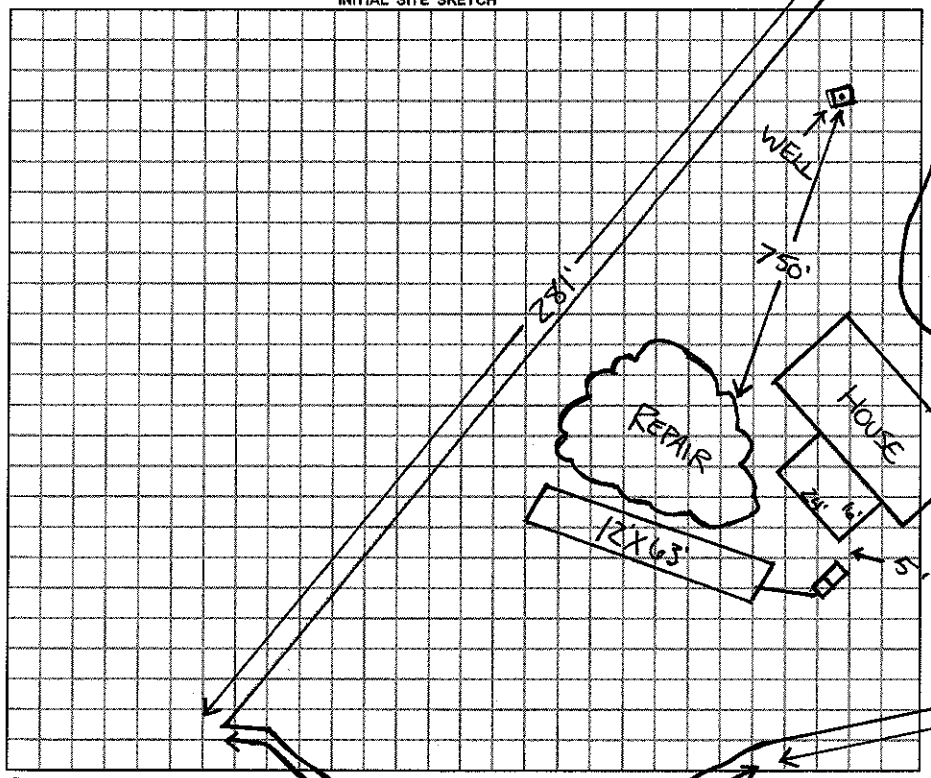

AS BUILT SKETCH

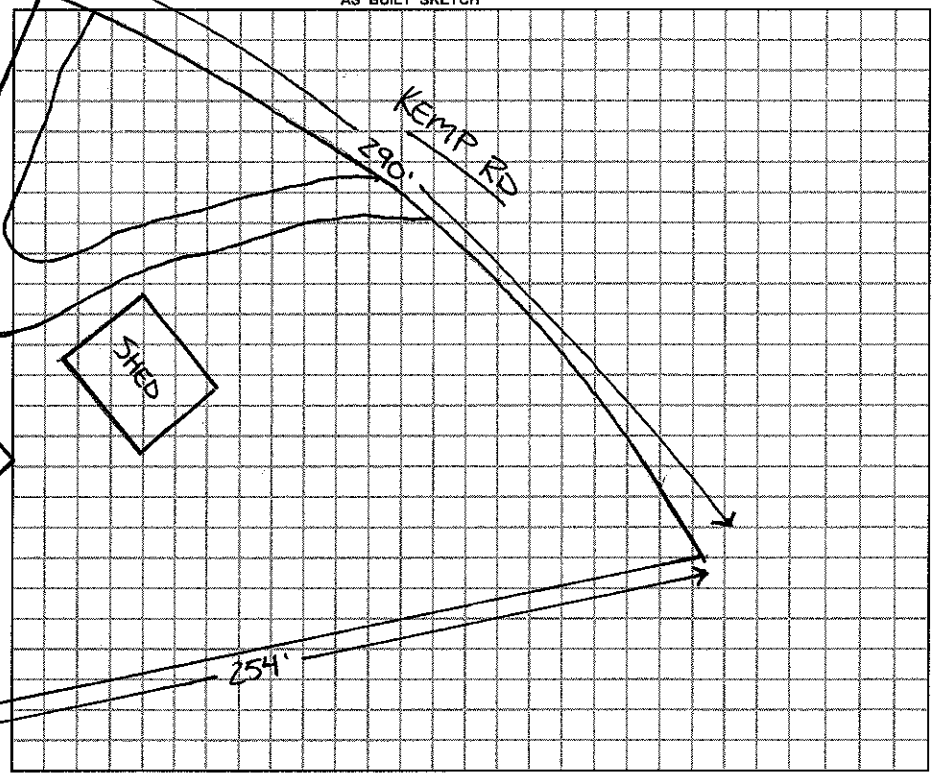

Permit can be suspended or revoked if any false information is supplied toward securing the permit / any unauthorized changes are made to the site / any unauthorized changes are made in the installation of the system.

☐ *IMPROVEMENT PERMIT w / plat valid without expiration.* ☐ *IMPROVEMENT PERMIT w / site plan valid for 60 mos.* ☐ *AUTHORIZATION TO CONSTRUCT valid for period equal to IMPROVEMENT PERMIT-not to exceed 60 mo.*

Owner / Applicant Signature: Charles Watts Date 1/5/10

Improvement Permit by: Date

Authorization to Construct by: Date

YOU SHOULD CONTACT A LOCATOR SERVICE PRIOR TO ANY EXCAVATION.

Installed by:

Operation Permit by: Date:

Existing System Inspected by: REHS Date: 12-31-09

WHITE COPY Environmental Health YELLOW COPY (Final) Owner / Applicant PINK COPY (Initial) Owner / Applicant