IREDELL COUNTY HEALTH DEPARTMENT

Statesville Phone TR 3-7271 Mooresville Phone No. 664-5281

PERMIT TO INSTALL SEPTIC TANK

Permit No. 29 Permit Date 3-1- 1973

Owner Mr. Glenn Address Concord

Installed By Harrison Robeson Address Kannapolis


Location of Property On 1447 Sec 8 Z 177

Tank		Capacity		Length of Lines		Fixtures	
Block	( )	1000	(✓)	225'	(✓)	No. of Baths	(2)
Precast	(✓)	1250	( )	250'	( )	Dishwasher	(no)
		1500	( )	Other		Garbage Grdr.	(no)
		Other				Other Washing Machine	

NOTIFY HEALTH DEPARTMENT AT LEAST EIGHT HOURS BEFORE TANK IS TO BE INSPECTED.

Final Inspection 3-1- 1973 Approved (✓) Disapprcved ( )

Remarks

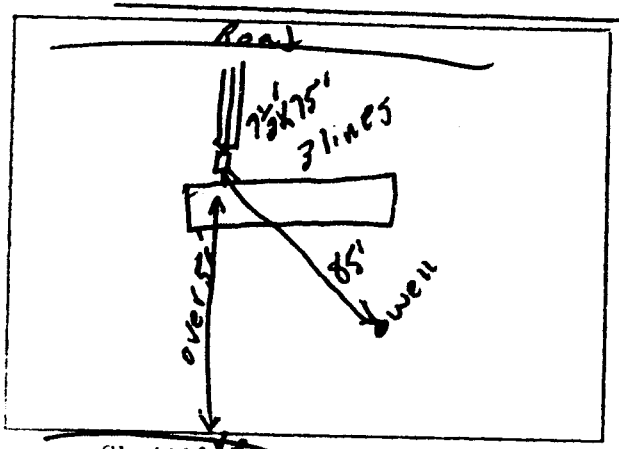

Sketch of Installation

J. C. Moore

Sanitarian