IREDELL COUNTY HEALTH DEPARTMENT

Repair permit 02

STATESVILLE 704-878-5305 MOORESVILLE 704-664-5281

2130

IMPROVEMENT PERMIT / AUTHORIZATION TO CONSTRUCT / OPERATION PERMIT / EXISTING SYSTEM INSPECTION

PERMIT# Repair PIN# Repair 4624165696 DATE 12-9-2002

OWNER OR CONTRACTOR Michael & Angela Jacobs PHONE: Business Home (704) 662-8413

ADDRESS 469 Kemp Rd Mooresville, NC

LOCATION Brawley School Rd TR McKendree TL Kemp Rd on left

SUBDIVISION CL&T BLOCK / SECTION 8 LOT 140 LOT AREA SITE CLASS. PS DESIGN FLOW 480 gpd L.T.A.R. .3

Septic Tank: Existing Gallons: STB Date

Pump Tank: Gallons: PT Date

Pump Make: Model Serial No.

Nitrification Field: No Fields Bed Square Feet 1200' Linear Feet 50'

No Lines Bed Trench Width 24' Max Trench Bottom Depth 36" Gravel Depth N/A

☐ New System ☒ Repair System Type: I, II, (III), IV, V, VI

System Description: Exist Gravity - Panel

Repair System Description: Gravity - 25% Reduction

Maintenance Agreement Required: ☑ Yes ☐ No

☒ House/Mod. Home No. Bedrooms 4

☐ Mobile Home No. Bathrooms 3.5

☐ Business No. Employees

☐ Other


☐ Slab ☒ Crawl Space ☐ Basement w/plumbing ☐ Basement wo/plumbing

Water Supply: ☒ Individual ☐ Public ☐ Community


Comments:/Conditions: Install Bed 50'X24' with 25% Reduction (Plastic Chamber or EZ Flow) Drainfield material Keep New Drainfield above Old Bed

Comments:/Conditions: * 25% Reduction in Drainfield area.

INITIAL SITE SKETCH Lake Norman * Not to Scale

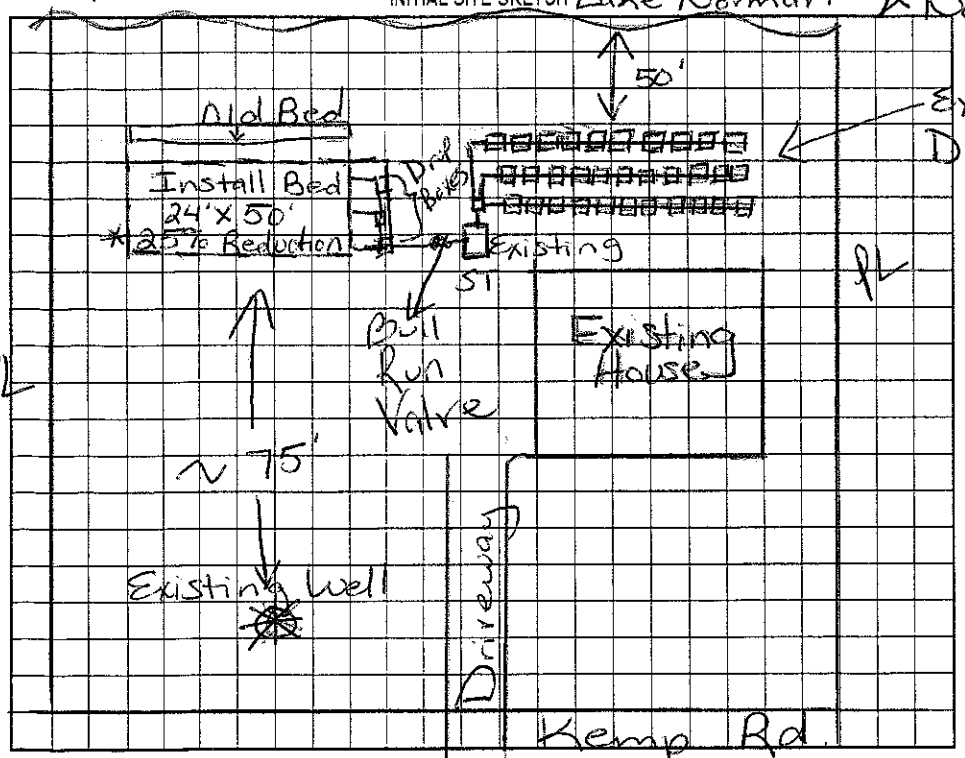

AS BUILT SKETCH

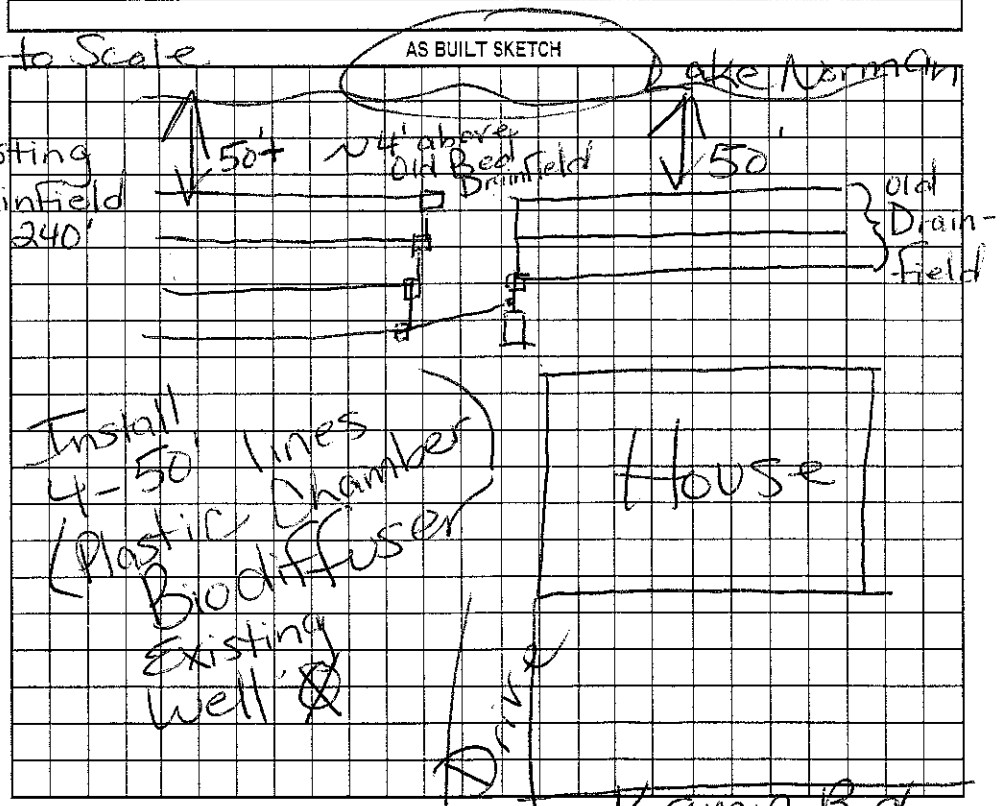

Permit can be suspended or revoked if any false information is supplied toward securing the permit/any unauthorized changes are made to the site/any unauthorized changes are made in the installation of the system. Improvement Permit with plat valid without expiration. Improvement Permit with site plan valid for sixty months. Authorization to Construct is valid for a period equal to that of Improvement Permit – not to exceed sixty months.

Signed: Angela M. Jacobs date 12-10-02 Installed by: Statesville Septic Service

Improvement Permit by: Maria H. H. Dotson RS date 12/9/02 Operation Permit by: Maria H. H. Dotson date 1/16/03

Authorization to Construct by: Maria H. H. Dotson RS date 12/9/02 Existing System Inspection by: date

HEALTH DEPT. COPY: WHITE OWNER COPY (FINAL): YELLOW OWNER COPY (INITIAL): PINK