4:00

IREDELL COUNTY HEALTH DEPARTMENT

STATESVILLE 704-878-5305 MOORESVILLE 704-664-5281

IMPROVEMENT PERMIT / AUTHORIZATION TO CONSTRUCT / OPERATION PERMIT / EXISTING SYSTEM INSPECTION

PERMIT# 144730 PIN# 4626166502 DATE 8-27-07

OWNER OR APPLICANT Rene & Chris White PHONE: Business 303-888-9181 Home 303-649-1082

ADDRESS 461 Kemp Rd Mooresville NC 28117

LOCATION Brawley School Rd TR McKendree TL Kemp 2 mi. on left 461 Kemp Rd

SUBDIVISION C L & T BLOCK / SECTION 8 LOT 139 LOT AREA .73 Ac SITE CLASS PS DESIGN FLOW 120gpd* L.T.A.R. .3gpd/ft²

Septic Tank: Existing Gallons: STB _____ Date _____

Pump Tank: _____ Gallons: PT _____ Date _____

Pump Make: _____ Model _____ Serial No. _____

Nitrification Field: No Fields 1 Square Feet _____ Linear Feet 68

No Lines 2@34' Trench Width 24" Max Trench Bottom Depth 40"* Gravel Depth NA ☒ Gravity ☐ Pressure

☐ New System ☐ Repair ☒ Expansion System Type: I II III IV V VI

System Description: PPBPS gravity

Repair System Description: PPBPS gravity **

Maintenance Agreement Required: ☐ Yes ☒ No

☒ House/Mod. Home ☐ Mobile Home ☐ Business ☐ Other

No. Bedrooms 4 No. Persons 8 No. Employees ____

Water Supply: ☒ Individual ☐ Public ☐ Community


☐ Slab ☐ Crawl Space ☒ Basement w/plumbing ☐ Basement wo/plumbing

Comments:/Conditions: Install 2 - 34' panel lines w/ D-Box and supply line w/ 1/8" per ft. fall from Existing D-Box

Adjust speed levelers so last line feeds last

1" = 50'


INITIAL SITE SKETCH

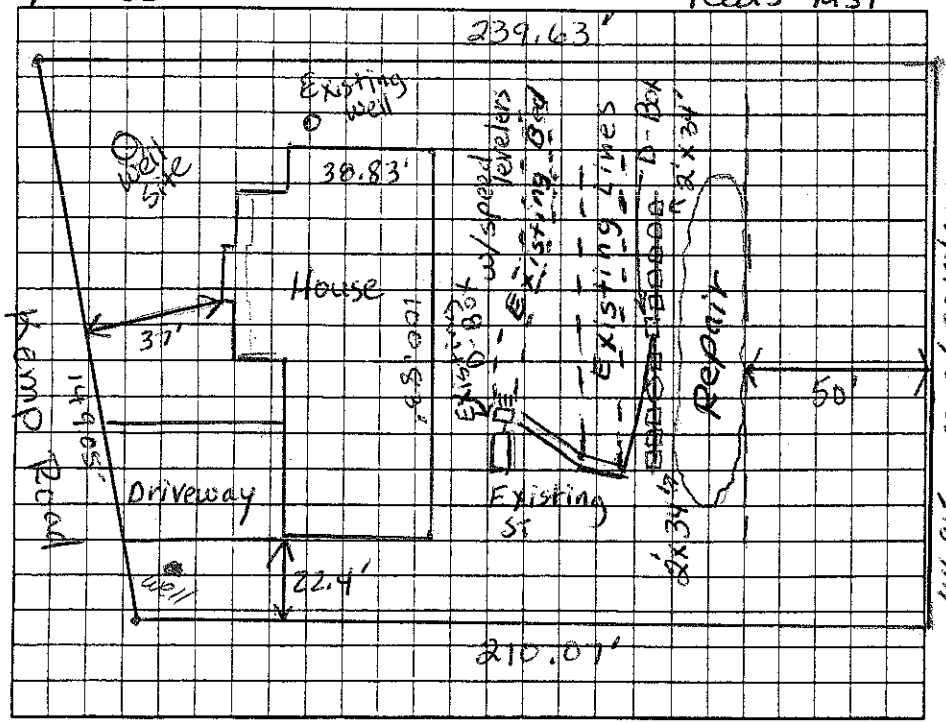

Comments:/Conditions: * Addition of 1 Bd. from 3Bd to 4Bd.

** Repair for 2 Bd. out of 4 Bd. original 2 Bd. system is pre-1983 therefore repair ~~does not apply~~ requirement does not apply. Rule .1945

AS BUILT SKETCH

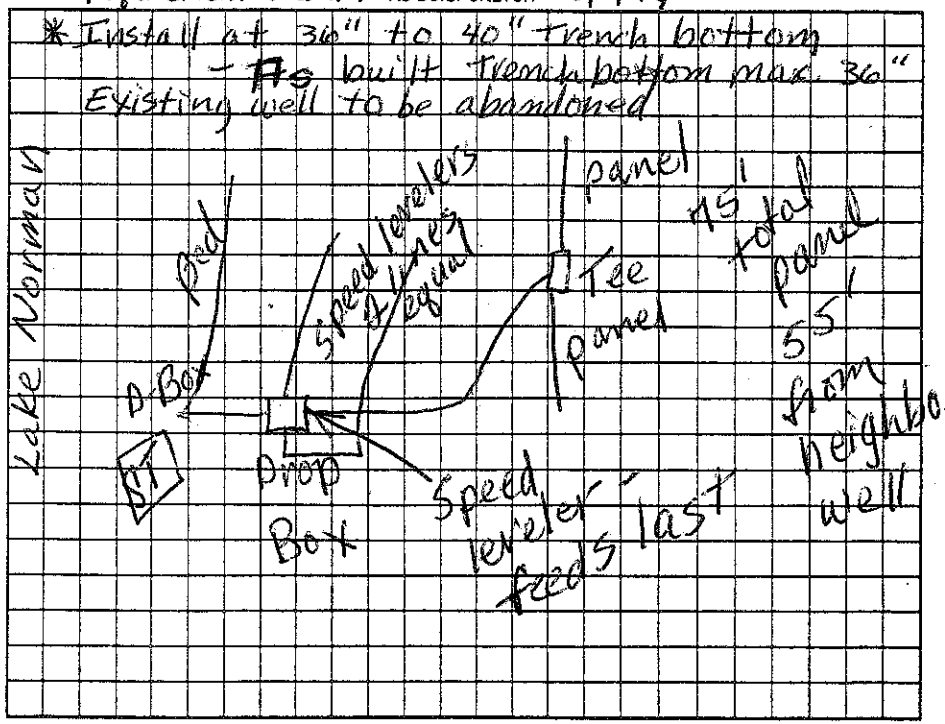

Permit can be suspended or revoked if any false information is supplied toward securing the permit/any unauthorized changes are made to the site/any unauthorized changes are made in the installation of the system. Improvement Permit with plat valid without expiration ☐ Improvement Permit with site plan valid for sixty months ☒ Authorization to Construct is valid for a period equal to that of Improvement Permit – not to exceed sixty months.

Signed: Stephen W. Tuttle date 9.5.07

Improvement Permit by: Judy Melville date 8-27-07

Authorization to Construct by: Judy Melville date 8-27-07

Installed by: Bucks Grading

Operation Permit by: Judy Melville date 12-19-07

Existing System Inspection by: _____ date _____

HEALTH DEPT. COPY: WHITE OWNER COPY (FINAL): YELLOW OWNER COPY (INITIAL): PINK

3:30

IREDELL COUNTY HEALTH DEPARTMENT

STATESVILLE 704-878-5305 MOORESVILLE 704-664-5281

IMPROVEMENT PERMIT / AUTHORIZATION TO CONSTRUCT / OPERATION PERMIT / EXISTING SYSTEM INSPECTION

PERMIT# 072774 PIN# 4626166502 DATE 5/14/98

OWNER OR CONTRACTOR JOSHUA. McKINNEY PHONE: Business Home 662-0893

ADDRESS 516-D RIVER HWY NO. 133 MOORESVILLE NC 28115

LOCATION BRAWLEY SCHOOL - TR McKENDREE, TL 1ST KEMP - ~ 2 MILES ON LT.

SUBDIVISION CL&T BLOCK / SECTION 8 LOT 139 LOT AREA — SITE CLASS. RS DESIGN FLOW 360 L.T.A.R. —

Septic Tank: EXISTING Gallons; STB Date

Pump Tank: Gallons; PT Date

Pump Make: Model Serial No.

Nitrification Field: No Fields 1 Square Feet 300 Linear Feet 100

No Lines 2@50' Trench Width 36" Max Trench Bottom Depth AS NEEDED Gravel Depth 12"

☑ New System ☐ Repair System Type: I (II) III, IV, V, VI

System Description: GRAVITY CONVENTIONAL

Repair System Description: PANEL

Maintenance Agreement Required: ☐ Yes ☐ No

☑ House/Mod. Home No. Bedrooms 3

☐ Mobile Home No. Bathrooms 2

☐ Business No. Employees

☐ Other


☐ Slab ☐ Crawl Space ☐ Basement w/plumbing ☐ Basement wo/plumbing

Water Supply:
~~Individual~~
☐ Public
☐ Community

Comments:/Conditions:

Comments:/Conditions:

INITIAL SITE SKETCH

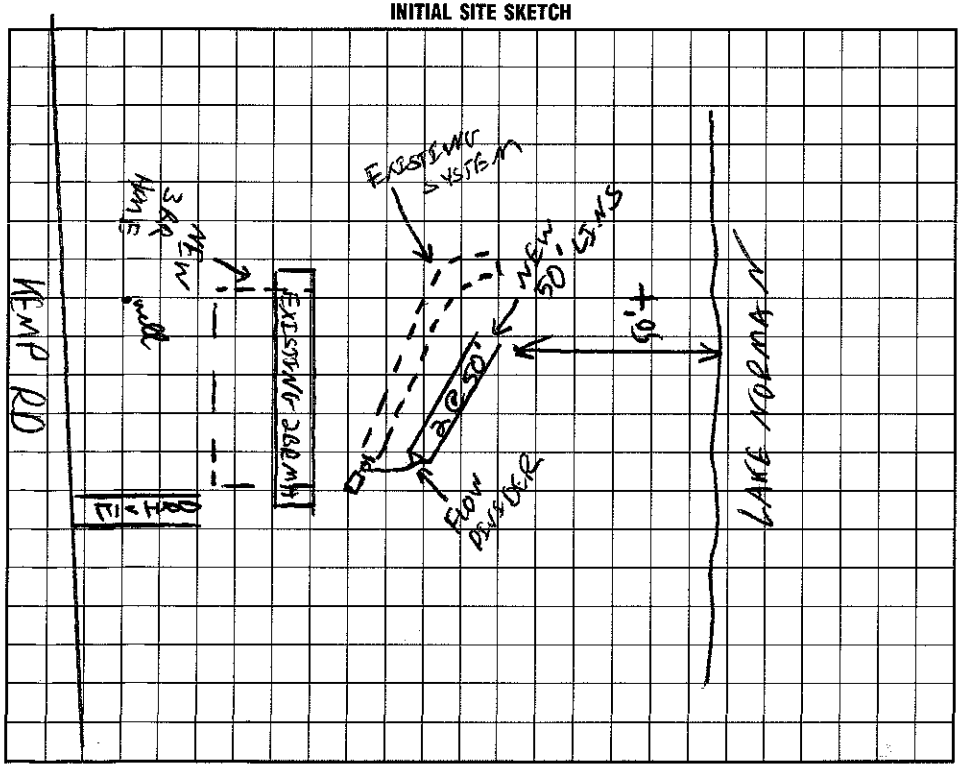

AS BUILT SKETCH

I understand that this permit can be suspended or revoked if any false information is supplied toward securing the permit/any unauthorized changes are made to the site/any unauthorized changes are made in the installation of the system. Improvement Permit with plat valid without expiration. Improvement Permit with site plan valid for sixty months. Authorization to Construct is valid for a period equal to that of Improvement Permit – not to exceed sixty months.

Signed: date 5-19-98

Improvement Permit by: C. RS date 5/14/98

Authorization to Construct by: C. RS date 5/14/98

Installed by: Kenny Madison

Operation Permit by: C. RS date 6/2/98

Existing System Inspection by: date

HEALTH DEPT. COPY: WHITE INSPECTION COPY (FINAL): GREEN OWNER COPY (FINAL): YELLOW INSPECTION COPY (INITIAL): PINK OWNER COPY (INITIAL): GOLD