IREDELL COUNTY HEALTH DEPARTMENT

STATESVILLE 704-878-5305 4626167054 MOORESVILLE 704-664-5281

IMPROVEMENT PERMIT / CERTIFICATE OF COMPLETION / OPERATION PERMIT / EXISTING SYSTEM INSPECTION

PROPERTY DESCRIPTION NO. 22141 DATE 10/10/95 TAX MAP NO. 2F 3A 135 Watershed: X Yes ☐ No

OWNER OR CONTRACTOR Don Weinbach PHONE: Business _____ Home 664-7727

ADDRESS 119 Pintland Ct. Mooresville NC 28115

LOCATION Kemp Rd. off McKendree ~ 1.5 miles on L

SUBDIVISION C L + T BLOCK / SECTION 8 LOT 135 LOT AREA 2.04 Ac SITE CLASS. PS DESIGN FLOW 360 L.T.A.R. .3

Septic Tank: 1000 Gallons; STB 794 Date 9-6-95
Pump Tank: _____ Gallons; PT _____ Date _____
Pump Make: _____ Model _____ Serial No. _____
Nitrification Field: No Fields 1 Square Feet 1200 Linear Feet 400
No Lines 4 Trench Width 36" Max Trench Bottom Depth 32" Gravel Depth 12"

X New System ☐ Repair System Type: I, (II), III, IV, V, VI
System Description: Gravity Conventional
Repair System Description: Same
Maintenance Agreement Required: ☐ Yes X No

X House/Mod. Home No. Bedrooms 3
☐ Mobile Home No. Bathrooms 2.5
☐ Business No. Employees _____
☐ Other _____


☐ Slab X Crawl Space ☐ Basement w/plumbing ☐ Basement wo/plumbing

Water Supply:
X Individual
☐ Community
☐ Public


Comments:

Comments:

INITIAL SITE SKETCH

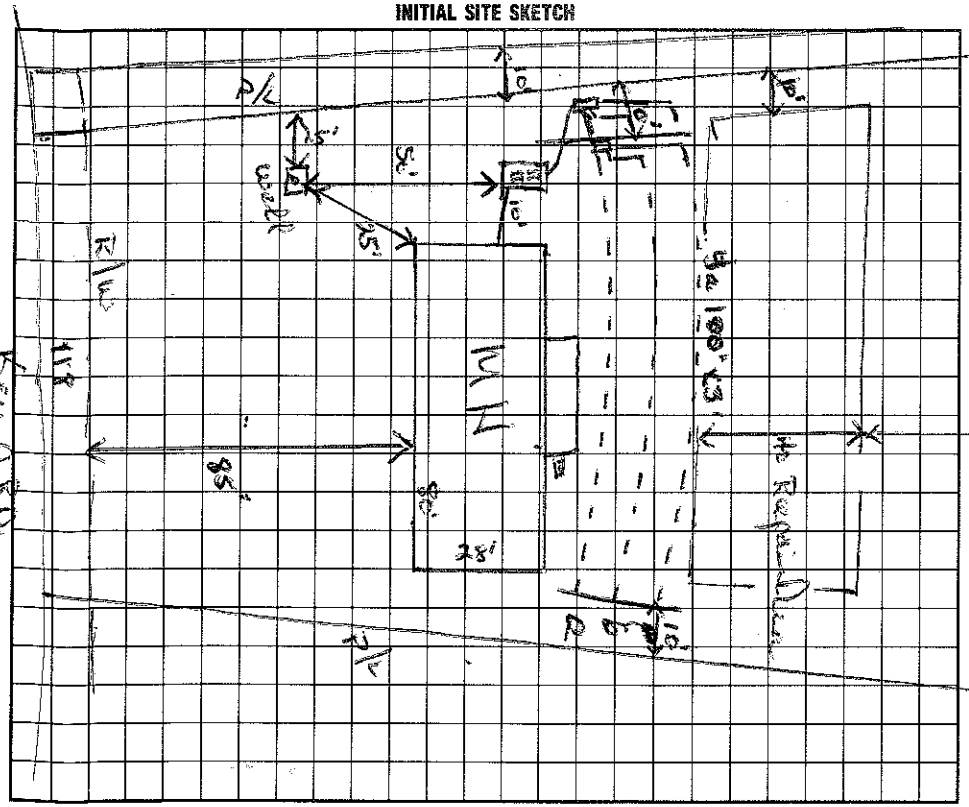

AS BUILT SKETCH

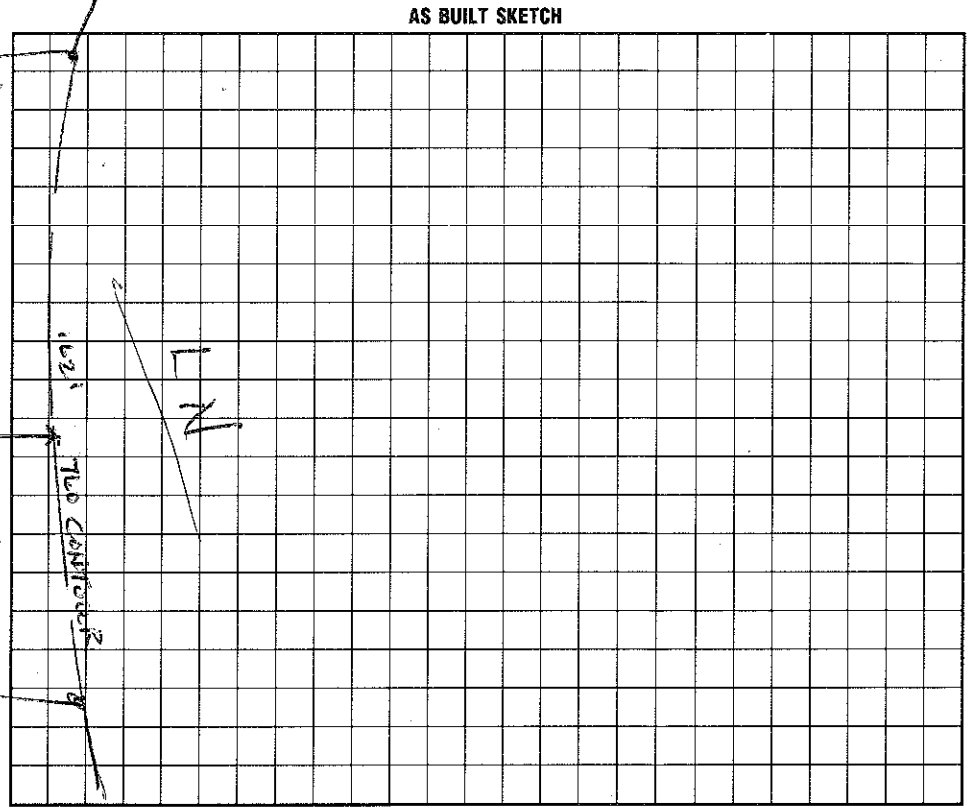

I understand that this permit can be suspended or revoked if any false information is supplied toward securing the permit/any unauthorized changes are made to the site/any unauthorized changes are made in the installation of the system.

Signed: X _____

Improvement Permit by: Wesley Sparks R.S. date 10/10/95

2nd Existing System Inspection by: ~~Steve Constant~~ Wesley Sparks R.S. date 10/10/95

Installed by: Richard Abernathy

Certificate of Completion by: Wesley Sparks R.S. date 11/20/95

Operation Permit by: Wesley Sparks R.S. date 11/20/95

HEALTH DEPT. COPY: WHITE INSPECTION COPY (FINAL): GREEN OWNER COPY (FINAL): YELLOW INSPECTION COPY (INITIAL): PINK OWNER COPY (INITIAL): GOLD