IREDELL COUNTY HEALTH DEPARTMENT

STATESVILLE 704-878-5305 MOORESVILLE 704-664-5281

IMPROVEMENT PERMIT / AUTHORIZATION TO CONSTRUCT / OPERATION PERMIT / EXISTING SYSTEM INSPECTION

PERMIT# 118746 PIN# 4626 38 4001.358 4626 16 8462 DATE 6/30/04

OWNER OR CONTRACTOR THE FARMS LLC / SIMONINI BLDRS. PHONE: Business 660-1185 Home

ADDRESS 2214 BRAWLEY SCHOOL RD. MOORESVILLE NC 28115

LOCATION BRAWLEY SCHOOL - TR McKNORREE - TL KEMP - TR ALDER SPRINGS - TL BAYBERRY - LOT ON LT - SEPTIC IN CIRCLE

SUBDIVISION THE FARMS BLOCK / SECTION 3 LOT 358 LOT AREA 1.83AC SITE CLASS. RS DESIGN FLOW 480GPD L.T.A.R. .36 GPD/FT2

Septic Tank: 1000 Gallons; STB 444 Date 9-4-06

Pump Tank: 1000 Gallons; PT 477 Date 8-25-06

Pump Make: Myers Model ME75 Serial No 2 10 A05

Nitrification Field No. Fields 1 Square Feet 1200 75 Linear Feet 500

No Lines 6 @ 83 Trench Width 36" Max Trench Bottom Depth 36" Gravel Depth N/A

☑ New System ☐ Repair System Type: I, II, III, IV, V, VI

System Description: PUMP OFFSITE 25% REDUCTION

Repair System Description: SAME

Maintenance Agreement Required: ☐ Yes ☑ No

☑ House/Mod. Home ☐ Mobile Home ☐ Business ☐ Other

No. Bedrooms 4 5 BRMS No. Bathrooms 4 No. Employees

Water Supply: ☐ Individual ☐ Public ☑ Community

☐ Slab ☐ Crawl Space ☑ Basement w/plumbing ☐ Basement wo/plumbing

Comments:/Conditions: SEE PLAT FOR SUPPLY LINE LOCATION.


Note: Pump = ME75

Comments:/Conditions: (Lines) Lines Checked 7/26/06 EZ Flow GW


Tanks Checked 10/9/06 MD

Pres. elect & alarm 1/11/07 MD

INITIAL SITE SKETCH

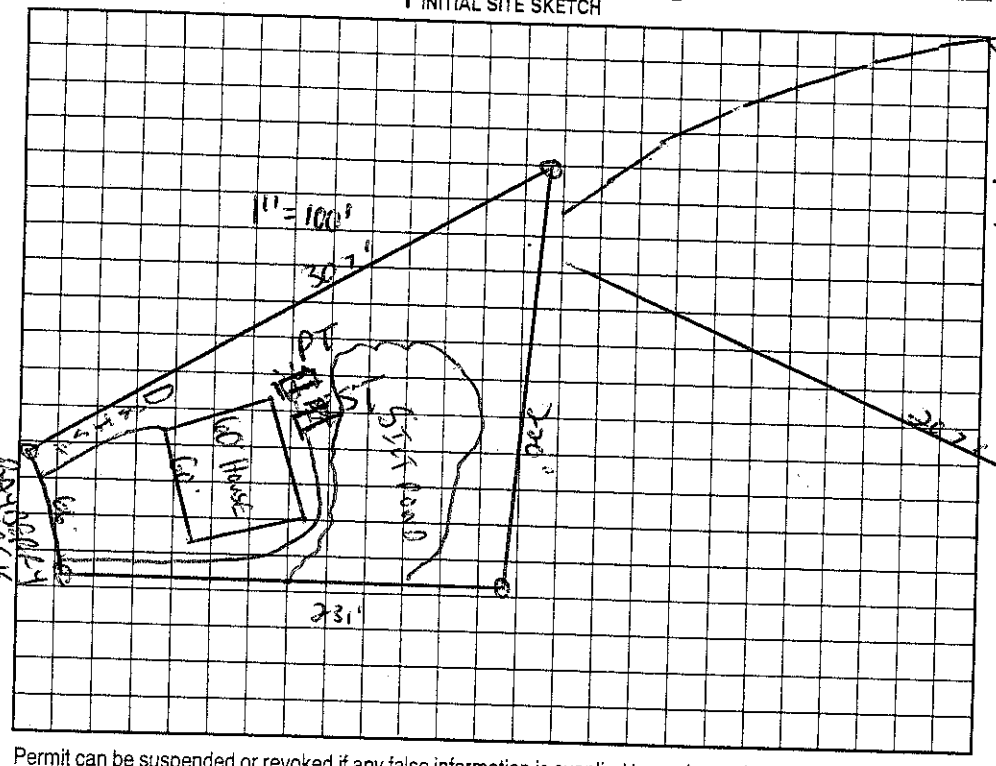

AS BUILT SKETCH

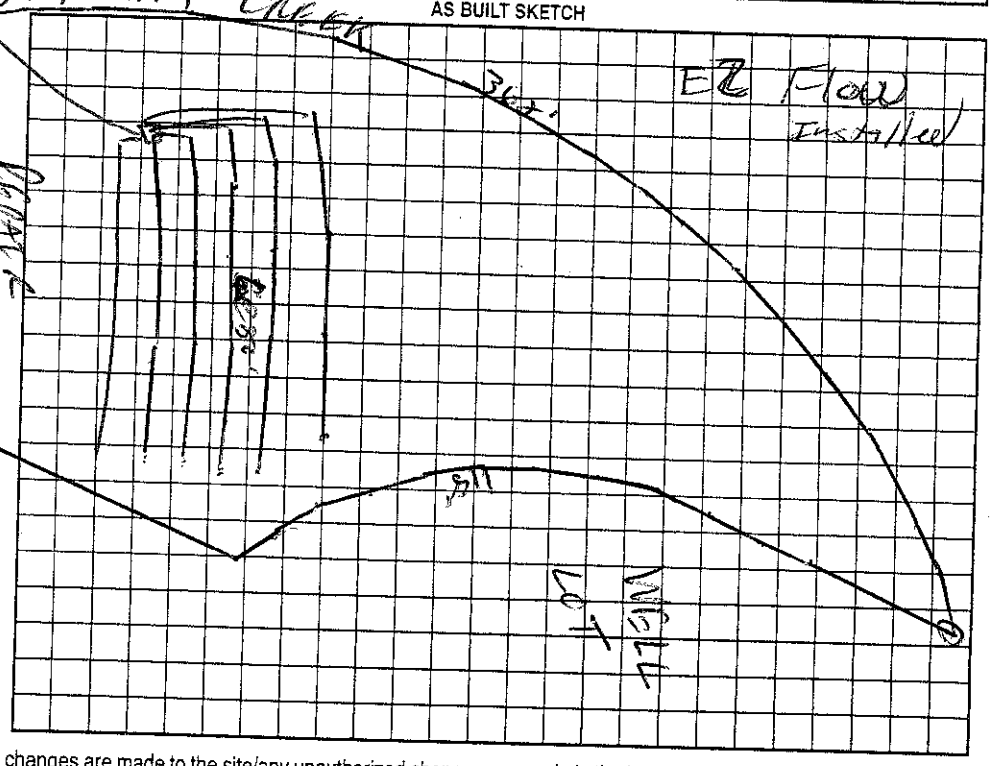

Permit can be suspended or revoked if any false information is supplied toward securing the permit/any unauthorized changes are made to the site/any unauthorized changes are made in the installation of the system. Improvement Permit with plat valid without expiration. Improvement Permit with site plan valid for sixty months. Authorization to Construct is valid for a period equal to that of Improvement Permit – not to exceed sixty months.

Signed: _____ date 7-18-07

Improvement Permit by: C. Jones RS date 6/30/04

Authorization to Construct by: Wesley Sparks RS date 6/1/06

Installed by: R+H RS

Operation Permit by: Marcia H. Dotson date 1/11/07

Existing System Inspection by: _____ date _____

HEALTH DEPT. COPY: WHITE OWNER COPY (FINAL): YELLOW OWNER COPY (INITIAL): PINK