400-8932 - JIM

IREDELL COUNTY HEALTH DEPARTMENT

STATESVILLE 704-878-5305 MOORESVILLE 704-664-5281

IMPROVEMENT PERMIT / AUTHORIZATION TO CONSTRUCT / OPERATION PERMIT / EXISTING SYSTEM INSPECT

PERMIT# ~~H8745~~ 171085 PIN# ~~4626754001357~~ 4626168547 DATE 6/28/07

OWNER OR CONTRACTOR THE FARMS LLC / T. Whelan Homes PHONE: Business 660-1185 Home

ADDRESS 224 BRAWLEY School Rd MOORESVILLE NC 28115

LOCATION BRAWLEY SCHOOL - TR McKENDREE - TL KEMP - TR KLOCK SPRINGS - TL BAYBERRY - ON LT.

SUBDIVISION THE FARMS BLOCK / SECTION 3 LOT 357 LOT AREA 1.67AC SITE CLASS. PS DESIGN FLOW 480GPD L.T.A.R. 1.36AC/Trs

Septic Tank: ~~1000~~ 1500 Gallons; STB 338 Date 9/19/12
Pump Tank: _____ Gallons; PT _____ Date _____
Pump Make: _____ Model _____ Serial No. _____
Nitrification Field: No Fields 1 Square Feet 1200 Linear Feet 400
No Lines 4@100' Trench Width 36" Max Trench Bottom Depth 36" Gravel Depth n/a

☑ New System ☐ Repair System Type: I, II, (III), IV, V, VI
System Description: GRAVITY 25% REDUCTION
Repair System Description: LP PANEL
Maintenance Agreement Required: ☐ Yes ☑ No

☐ ~~House/Mod.~~ Home No. Bedrooms 4
☐ Mobile Home No. Bathrooms 4
☐ Business No. Employees
☐ Other

☐ Slab ☑ Crawl Space ☐ Basement w/plumbing ☐ Basement wo/plumbing


Water Supply:
☐ Individual
☐ Public
☑ Community

Comments:/Conditions: 2/28/2012 Reviewed Floor plans, in Compliance with permit.
* Septic System must be installed & Completed by 6/28/2013

Comments:/Conditions:

1"=50'

INITIAL SITE SKETCH

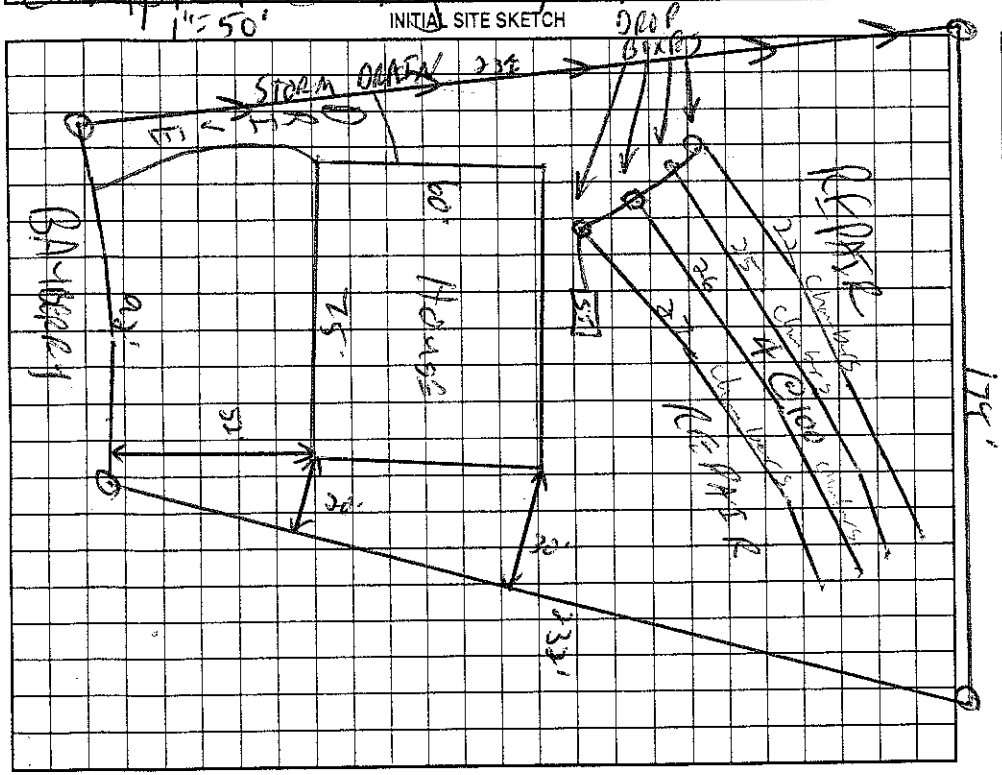

AS BUILT SKETCH

Installed substantially as shown

Permit can be suspended or revoked if any false information is supplied toward securing the permit/any unauthorized changes are made to the site/any unauthorized changes are made in the installation of the system. Improvement Permit with plat valid without expiration. Improvement Permit with site plan valid for sixty months. Authorization to Construct is valid for a period equal to that of Improvement Permit – not to exceed sixty months.

Signed: _____ date 7-12-07 Installed by: LE BEAM

Improvement Permit by: _____ date 6/28/07 Operation Permit by: C. Brady Trent HS date 10/23/12

Authorization to Construct by: _____ date 7-10-07 Existing System Inspection by: _____ date _____

Reissued by Maina Dobson 2/28/12

HEALTH DEPT COPY: WHITE OWNER COPY (FINAL): YELLOW OWNER COPY (INITIAL): PINK