11:30

IREDELL COUNTY HEALTH DEPARTMENT

STATESVILLE 704-878-5305 MOORESVILLE 704-664-5281

IMPROVEMENT PERMIT / AUTHORIZATION TO CONSTRUCT / OPERATION PERMIT / EXISTING SYSTEM INSPECTION

PERMIT# 118744 PIN# ~~4626384001.356~~ 4626-16-8688 DATE 4-10-06

OWNER OR APPLICANT Strom Construction PHONE: Business (704) 506-4000 Home 828 478-9460

ADDRESS 2343 Crofte Dr Sherrills Ford, NC 28673

LOCATION Brawley School TR McKendree TL Kemp TR Alder Springs TL Bayberry on left

SUBDIVISION The Farms BLOCK / SECTION 3 LOT 356 LOT AREA .75 Acre SITE CLASS. PS DESIGN FLOW 480 gpd L.T.A.R. .3

Septic Tank: 1000+1500 Gallons; STB 444 Date 7-9-06
Pump Tank: 1000 Gallons; PT 283 Date 7-9-06
Pump Make: Myers Model ME 50S-21 Serial No.
Nitrification Field: No Fields 1 Square Feet 825 Linear Feet 275
No Lines 3 Trench Width ~~See Note~~ Max Trench Bottom Depth 36" Gravel Depth N/A

[X] New System [ ] Repair [ ] Expansion System Type: I II III (IV) V VI
System Description: Pump-LP-Panel Black
Repair System Description: Same
Maintenance Agreement Required: [X] Yes [ ] No

[X] House/Mod. Home No. Bedrooms 4
[ ] Mobile Home No. Persons
[ ] Business No. Employees
[ ] Other

Water Supply: [ ] Individual [ ] Public [X] Community

[ ] Gravity [ ] Pressure [ ] Slab [X] Crawl Space [ ] Basement w/plumbing [ ] Basement wo/plumbing


½ hp

Comments/Conditions: * Use trench width Specified in Crescent Communities On Site Sewage Manual

Comments/Conditions:
Blue Polylok filter ST pressure bell set
septic tank w/risers
pump tank w/risers 3' pressure head set

Scale 1:50

INITIAL SITE SKETCH

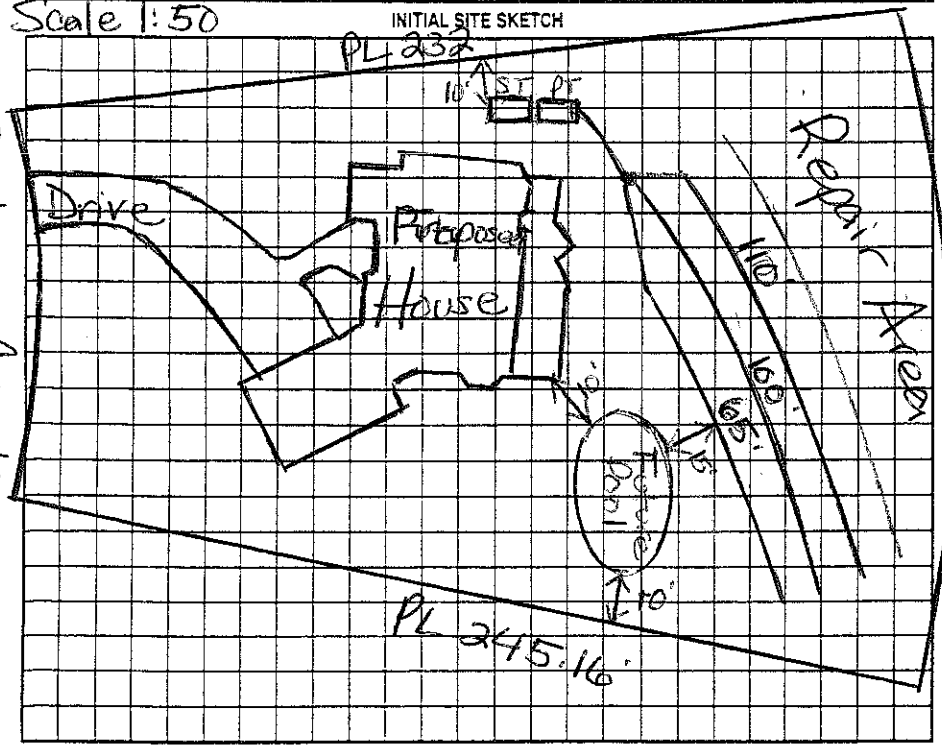

AS BUILT SKETCH

System installed as per initial site sketch

Permit can be suspended or revoked if any false information is supplied toward securing the permit/any unauthorized changes are made to the site/any unauthorized changes are made in the installation of the system. Improvement Permit with plat valid without expiration ☐ Improvement Permit with site plan valid for sixty months ☐ Authorization to Construct is valid for a period equal to that of Improvement Permit – not to exceed sixty months.

Signed: Courtney N. Ramsdell date 4/11/06 Installed by: Stanley Septic

Improvement Permit by: Maria H. Dotson RS date 4/10/06 Operation Permit by: Andy McNeill date 8-21-06

Authorization to Construct by: Maria H. Dotson RS date 4/10/06 Existing System Inspection by: date

HEALTH DEPT. COPY: WHITE OWNER COPY (FINAL): YELLOW OWNER COPY (INITIAL): PINK