10:09

IREDELL COUNTY HEALTH DEPARTMENT

STATESVILLE 704-878-5305 MOORESVILLE 704-664-5281

IMPROVEMENT PERMIT / AUTHORIZATION TO CONSTRUCT / OPERATION PERMIT / EXISTING SYSTEM INSPECTION

PERMIT# 118747 PIN# 4626 38 4001 . 359 DATE 6/24/04

OWNER OR CONTRACTOR THE FARMS LLC/Simonini Bldrs. PHONE: Business 660-1155 Home

ADDRESS 2214 BRAWLEY SCHOOL RD - MOORESVILLE NC 28115

LOCATION BRAWLEY SCHOOL - TR McKENDREE - TL KEMP - TR ALDER - TL BAYBERRY - ON RT IN CIRCLE

SUBDIVISION THE FARMS BLOCK / SECTION 3 LOT 359 LOT AREA 1.1 AC SITE CLASS. PS DESIGN FLOW 450GAD L.T.A.R. .36-.40/.42

Septic Tank: 1000 Gallons; STB 338 Date 8-8-05
Pump Tank: 1000 Gallons; PT Date
Pump Make: Model Serial No.
Nitrification Field: No Fields 1 Square Feet 1440 Linear Feet 480
No Lines 4@120' Trench Width 36" Max Trench Bottom Depth 36" Gravel Depth N/A

☑ New System ☐ Repair System Type: I, II, III, IV, V, VI
System Description: PUMP 25% REDUCTION
Repair System Description: LP PANEL
Maintenance Agreement Required: ☐ Yes ☑ No

☑ House/Mod. Home No. Bedrooms 4
☐ Mobile Home No. Bathrooms 4
☐ Business No. Employees
☐ Other
☐ Slab ☑ Crawl Space ☐ Basement w/plumbing ☐ Basement wo/plumbing


Water Supply: ☐ Individual ☐ Public ☑ Community

Comments:/Conditions:


1"=50'

Comments:/Conditions: Checked tanks & lines 9/13/05

INITIAL SITE SKETCH

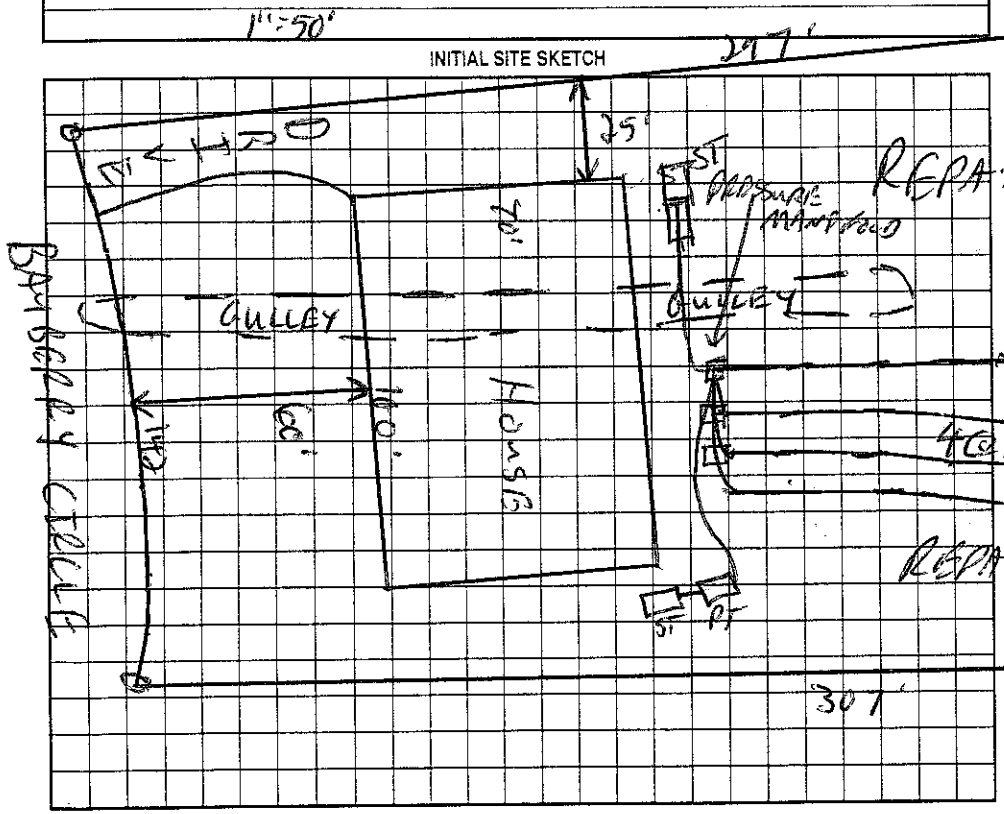

AS BUILT SKETCH

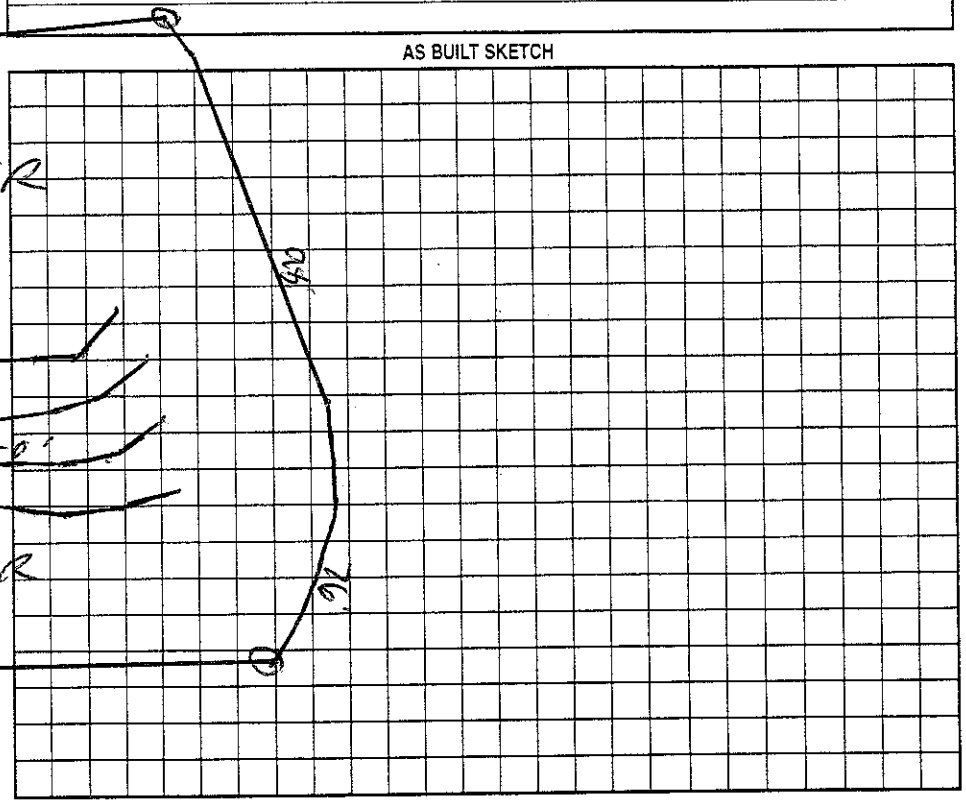

Permit can be suspended or revoked if any false information is supplied toward securing the permit/any unauthorized changes are made to the site/any unauthorized changes are made in the installation of the system. Improvement Permit with plat valid without expiration. Improvement Permit with site plan valid for sixty months. Authorization to Construct is valid for a period equal to that of Improvement Permit – not to exceed sixty months.

Signed: date 7-12-04 Installed by: R & H

Improvement Permit by: date 6/24/04 Operation Permit by: date 9/14/05

Authorization to Construct by: date 3/22/05 Existing System Inspection by: date

HEALTH DEPT. COPY: WHITE OWNER COPY (FINAL): YELLOW OWNER COPY (INITIAL): PINK