IREDELL COUNTY HEALTH DEPARTMENT

STATESVILLE 704-878-5305 MOORESVILLE 704-664-5281

IMPROVEMENT PERMIT / AUTHORIZATION TO CONSTRUCT / OPERATION PERMIT / EXISTING SYSTEM INSPECTION

PERMIT# 11843 PIN# ~~4626-38-4001.355~~ 4626 16 9759 DATE

OWNER OR APPLICANT Shaun Ogden PHONE: Business Home

ADDRESS

LOCATION RSR, TR McKendree, TL Kemp, TR Alder Springs, TL Bayberry on Lt

SUBDIVISION The Farms BLOCK / SECTION 3 LOT 355 LOT AREA 0.77Ac SITE CLASS. P5 DESIGN FLOW 480 L.T.A.R. 0.3

Septic Tank: 1000 Gallons; STB 338 Date 2-6-07

Pump Tank: ~~3~~ Gallons; PT Date

Pump Make: Model Serial No.

Nitrification Field: No Fields Square Feet 1200 Linear Feet 400

No Lines 4@100' Trench Width 36" Max Trench Bottom Depth 36" Gravel Depth

☒ New System ☐ Repair ☐ Expansion System Type: I II III IV V VI

System Description: 25% Reduction

Repair System Description: LP Gravel Block

Maintenance Agreement Required: ☐ Yes ☒ No

☒ Gravity ☐ Pressure

☒ House/Mod. Home No. Bedrooms 4

☐ Mobile Home No. Persons

☐ Business No. Employees

☐ Other

Water Supply: ☐ Individual ☐ Public ☒ Community


☐ Slab ☒ Crawl Space ☐ Basement w/plumbing ☐ Basement wo/plumbing

Comments:/Conditions:


Comments:/Conditions:

1"=50'

INITIAL SITE SKETCH

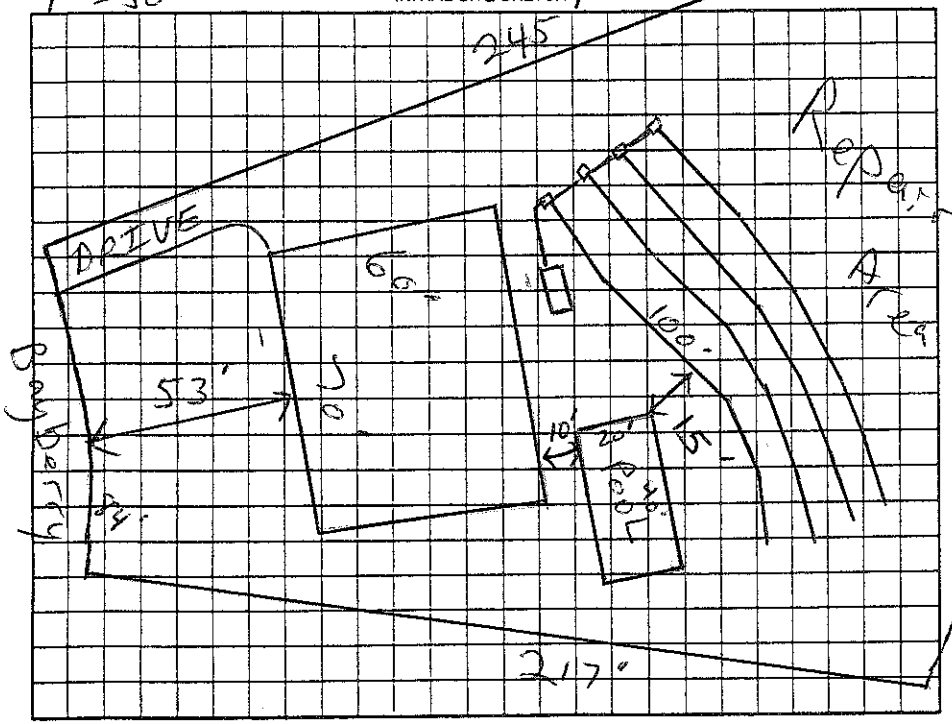

AS BUILT SKETCH

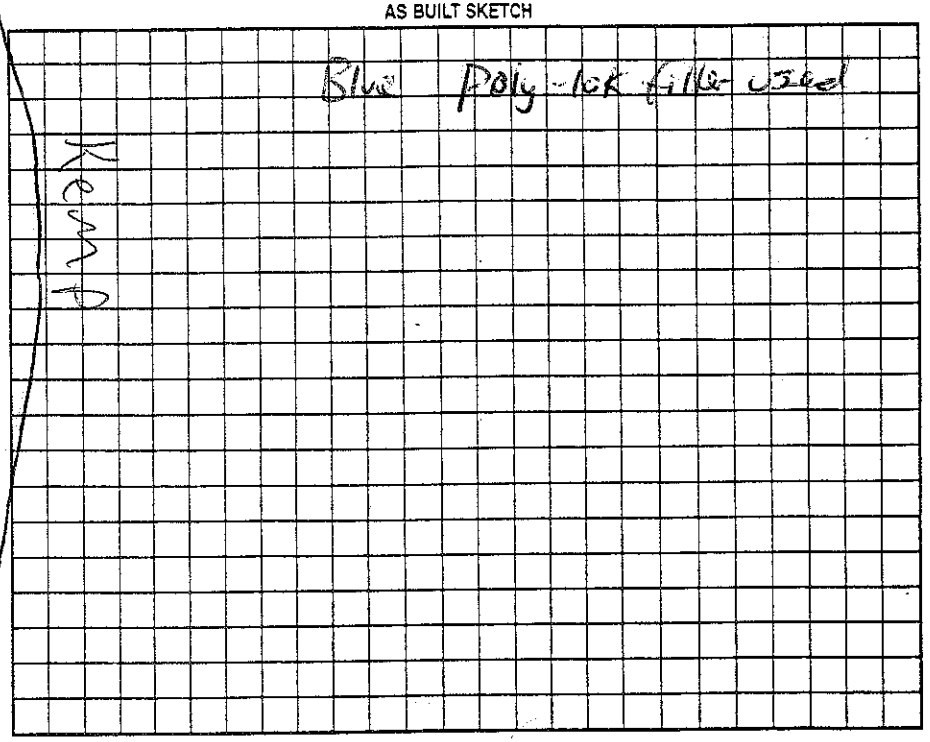

Permit can be suspended or revoked if any false information is supplied toward securing the permit/any unauthorized changes are made to the site/any unauthorized changes are made in the installation of the system. Improvement Permit with plan valid without expiration. ☐ Improvement Permit with site plan valid for sixty months ☐ Authorization to Construct is valid for a period equal to that of Improvement Permit – not to exceed sixty months.

Signed: Ogden date 9-8-06

Improvement Permit by: RS date 9/5/06

Authorization to Construct by: RS date 10/5/06

Installed by: Richard Hoornaert

Operation Permit by: date 4-5-07

Existing System Inspection by: date

HEALTH DEPT. COPY: WHITE OWNER COPY (FINAL): YELLOW OWNER COPY (INITIAL): PINK