IREDELL COUNTY HEALTH DEPARTMENT

STATESVILLE 704-878-5305 MOORESVILLE 704-664-5281

IMPROVEMENT PERMIT / AUTHORIZATION TO CONSTRUCT / OPERATION PERMIT / EXISTING SYSTEM INSPECTION

PERMIT # 1605455 PIN # 4626173512 DATE 3-8-2011

OWNER or APPLICANT Sustainable Contractors / Robert Bode PHONE: Business 7049418-9881 Home: 634-8735 Stewart

OWNER or APPLICANT ADDRESS 1848 Briarcrest Dr Charlotte NC 28269

LOCATION / DIRECTIONS Brawley School Rd TR McKendree TL Kemp Rd #667

SUBDIVISION CLAT BLOCK / SECTION 8 LOT # 165 LOT AREA .871AC DESIGN FLOW 360gpd L.T.A.R.

Existing

Septic Tank 1600 Gallons: STB Date

Pump Tank Gallons: P T Date

Pump Make Model Serial #

Nitrification Field No Fields 1 No Lines Linear Feet *160ft

Trench Width *5ft Max. Trench Bottom Depth Gravel Depth

☐ New System ☐ Repair ☐ Expansion System Type I II III IV V VI (Existing)

System Description: Gravity - Gravel Bed (Conv.)

Repair System Description: Modified Conv.

Maintenance Agreement Required ☐ YES ☒ NO

☒ GRAVITY ☐ PRESSURE

☒ Residence No. Bedrooms 3*

☐ Business No. Persons

☐ Other No. Employees

☐ Slab ☐ Crawl Space

☐ Basement w/plumbing ☐ Basement w/o plumbing

Water Supply: ☒ Private ☐ Public ☐ Community

Comments / Conditions * Existing Gravity Conventional Gravel Bed ~5' X 60'

* per owner # of Bedrooms = 3


Comments / Conditions Existing Septic Appears to be Functioning Okay at Time of Inspection

* However, house is not lived in Full Time.

Replacing Stairs & adding 4'X8' deck

Should not Impact Septic System.

INITIAL SITE SKETCH

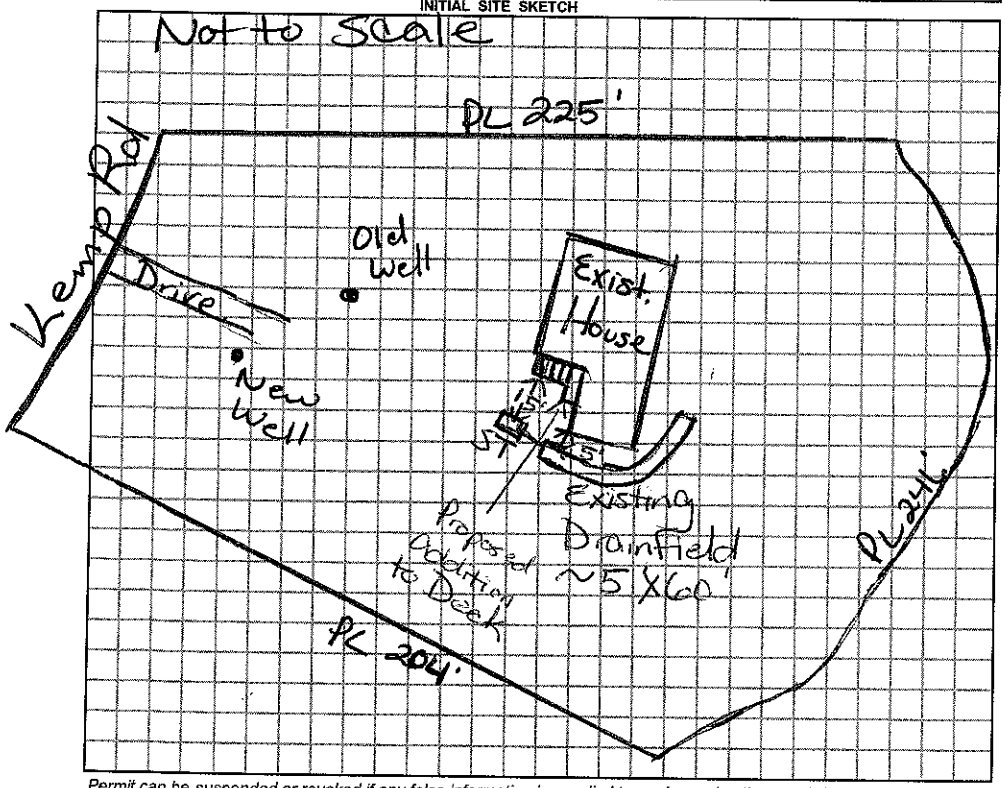

AS BUILT SKETCH

Lake Norman

Permit can be suspended or revoked if any false information is supplied toward securing the permit / any unauthorized changes are made to the site / any unauthorized changes are made in the installation of the system.

☐ *IMPROVEMENT PERMIT w / plan valid without expiration.* ☐ *IMPROVEMENT PERMIT w / site plan valid for 60 mos.* ☐ *AUTHORIZATION TO CONSTRUCT valid for period equal to IMPROVEMENT PERMIT-not to exceed 60 mo.*

Owner / Applicant Signature: Robert Bode Date 3-9-2011

Improvement Permit by: Date

Authorzation to Construct by: Date

YOU SHOULD CONTACT A LOCATOR SERVICE PRIOR TO ANY EXCAVATION.

Installed by:

Operation Permit by: Date:

Existing System Inspected by: Miranda Dotson RS Date: 3/8/11

WHITE COPY Environmental Health YELLOW COPY (Final) Owner / Applicant PINK COPY (Initial) Owner / Applicant