IREDELL COUNTY HEALTH DEPARTMENT

Statesville Phone TR 3-7271 Mooresville Phone NO 3-1271

PERMIT TO INSTALL SEPTIC TANK

Permit No. _____ Permit Date 23 Oct. 1968

Owner J W. Davis Address Charlotte, N.C.

Installed By Honeycutt & Orbanosk Address Mooresville, N.C.


Location of Property Sect. 8 165

Tank		Capacity		Length of Lines		Fixtures	
Block	( )	1000	(✓)	225'	( )	No. of Baths	( )
Precast	(✓)	1250	( )	250'	( )	Dishwasher	( )
		1500	( )	Other _____		Garbage Grdr.	( )
		Other _____				Other _____	

NOTIFY HEALTH DEPARTMENT AT LEAST EIGHT HOURS BEFORE TANK IS TO BE INSPECTED.

Final Inspection 23 Oct. 1968 Approved (X) Disapproved ( )

Remarks _____

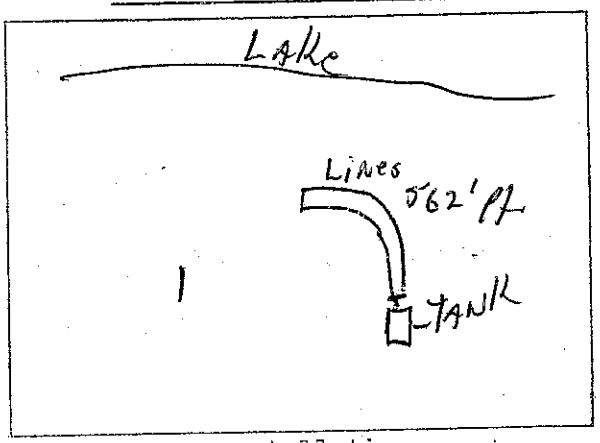

Sketch of Installation

Greg R. Scoggins RS

Sanitarian