IREDELL COUNTY HEALTH DEPARTMENT

STATESVILLE 704-878-5305 MOORESVILLE 704-664-5281

4626173849 13

IMPROVEMENT PERMIT / AUTHORIZATION TO CONSTRUCT / OPERATION PERMIT / EXISTING SYSTEM INSPECTION

PERMIT# 18581 PIN# 4626 38 4001.307 DATE 12/30/04

OWNER OR CONTRACTOR THE FARMS LLC / HHZ PHONE: Business Home

ADDRESS 224 BRAWLEY SCHOOL RD MOORESVILLE NC 28115

LOCATION BRAWLEY SCHOOL - TR McKENDREE - TR BAYBERRY-ON RT

SUBDIVISION THE FARMS BLOCK / SECTION 3 LOT 307 LOT AREA .82AC SITE CLASS PS DESIGN FLOW 480GD L.T.A.R. .3100/R

Septic Tank: 1000 Gallons; STB 338 Date 12-14-05

Pump Tank: Gallons; PT Date

Pump Make: Model Serial No.

Nitrification Field: No Fields 1 Square Feet 1200 Linear Feet 400

No Lines 4@100' Trench Width 36" Max Trench Bottom Depth 36" Gravel Depth N/A

☑ New System ☐ Repair System Type: I II III IV V VI

System Description: GRAVITY 35% REDUCTION

Repair System Description: LP PANEL

Maintenance Agreement Required: ☐ Yes ☐ No

☑ House/Mod. Home ☐ Mobile Home ☐ Business ☐ Other

No. Bedrooms 4 No. Bathrooms 4 No. Employees

☐ Slab ☑ Crawl Space ☐ Basement w/plumbing ☐ Basement wo/plumbing


Water Supply: ☐ Individual ☐ Public ☑ Community

Comments:/Conditions: Reviewed Building plans & site plan; essentially in compliance with I.P.


1"=50'

Comments:/Conditions:

INITIAL SITE SKETCH

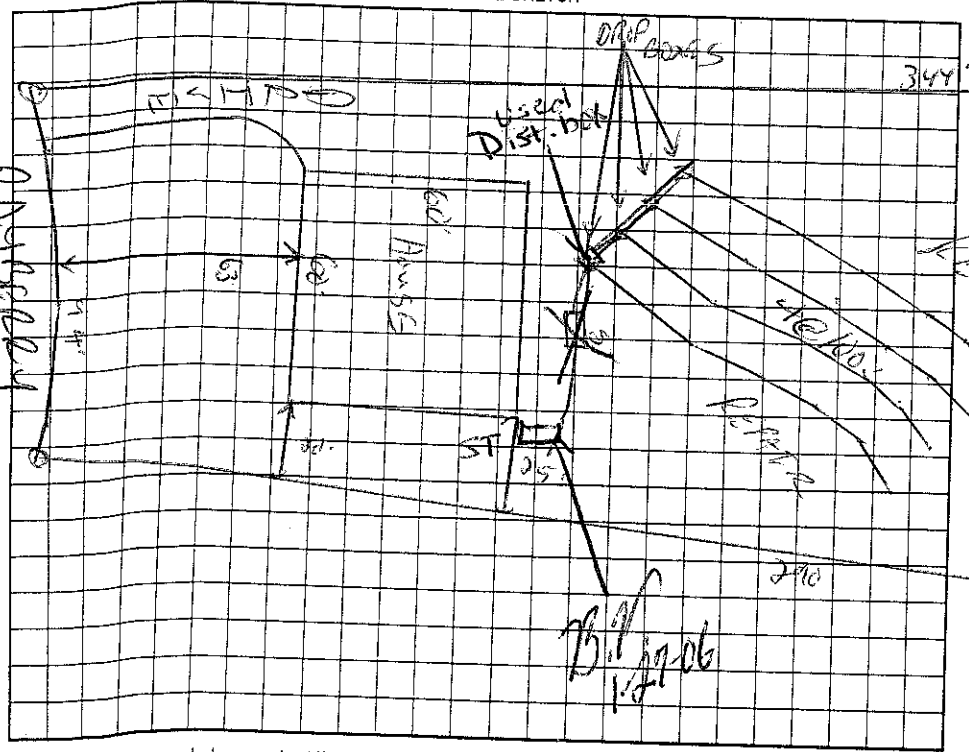

AS BUILT SKETCH

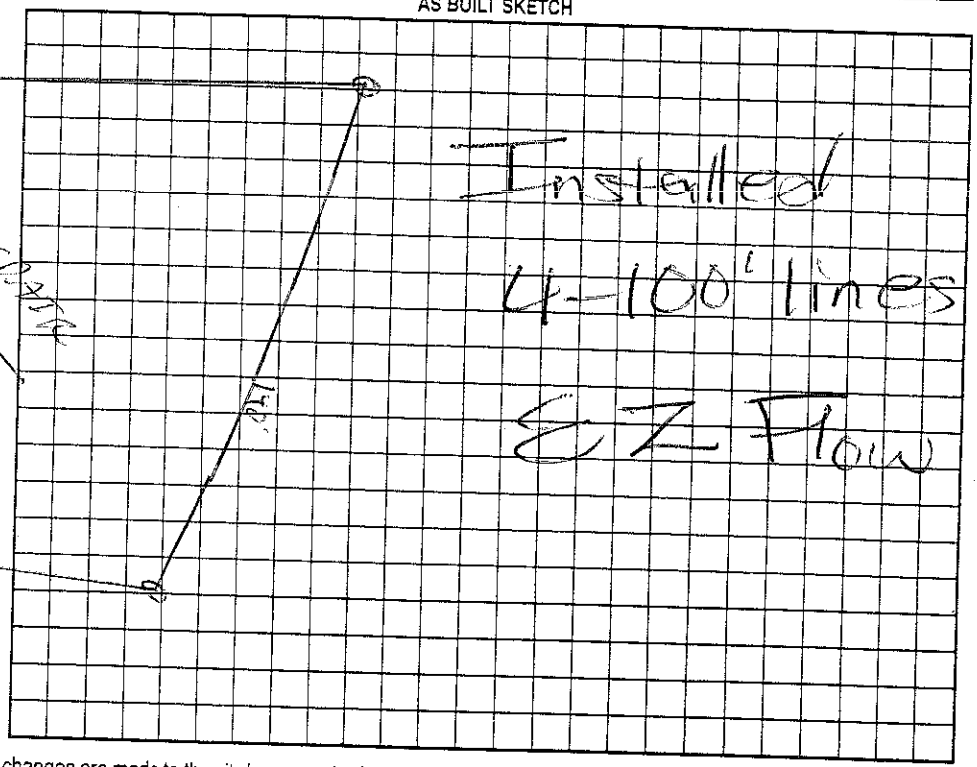

Permit can be suspended or revoked if any false information is supplied toward securing the permit/any unauthorized changes are made to the site/any unauthorized changes are made in the installation of the system. Improvement Permit with plat valid without expiration. Improvement Permit with site plan valid for sixty months. Authorization to Construct is valid for a period equal to that of Improvement Permit – not to exceed sixty months.)

Signed: date 2-24-05 Installed by: Bobby Mayhew

Improvement Permit by: date 12/30/04 Operation Permit by: date 1/27/06

Authorization to Construct by: date 8/4/05 Existing System Inspection by: date

HEALTH DEPT. COPY: WHITE OWNER COPY (FINAL): YELLOW OWNER COPY (INITIAL): PINK