Repair

IREDELL COUNTY HEALTH DEPARTMENT

STATESVILLE 704-878-5305 MOORESVILLE 704-664-5281

IMPROVEMENT PERMIT / AUTHORIZATION TO CONSTRUCT / OPERATION PERMIT / EXISTING SYSTEM INSPECTION

PERMIT# Repair PIN# N/A 4626 17 4581 DATE 3/8/2007

OWNER OR CONTRACTOR Tom Lasitter PHONE: Business Home 664-6247

ADDRESS 663 Kemp Rd Mooresville NC 28117

LOCATION Brawley School Rd TR McKendree 2nd Kemp Rd TL & TL again

SUBDIVISION CLTJ BLOCK / SECTION 8 LOT LOT AREA SITE CLASS PS DESIGN FLOW J L.T.A.R. .25 to .3

Septic Tank: Existing Gallons; STB Date

Pump Tank: Gallons; PT Date

Pump Make: Model Serial No.

Nitrification Field: No Fields 1 Square Feet Linear Feet ~55'

No Lines Bed (4 lines) Trench Width 12' to 15' Max Trench Bottom Depth 36" Gravel Depth 12" + ☐ Slab ☒ Crawl Space ☐ Basement w/plumbing ☐ Basement wo/plumbing

☐ New System ☒ Repair System Type: I, II, III, IV, V, VI

System Description: Gravity - Conventional

Repair System Description: Gravity - Conventional 25% Reduction

Maintenance Agreement Required: ☐ Yes ☐ No

☒ House/Mod. Home No. Bedrooms 3

☐ Mobile Home No. Bathrooms 2.5

☐ Business No. Employees

☐ Other


Water Supply: ☒ Individual ☐ Public ☐ Community

Comments:/Conditions:

Install Bed ~12' to 15' X 55' Keep at least 50' from lake & 50' from well. Use Existing Septic tank if in good condition.

Comments:/Conditions: Install "Bull Run Valve" Replaced Sanitary "T" in tank.

INITIAL SITE SKETCH ☆ Not to Scale

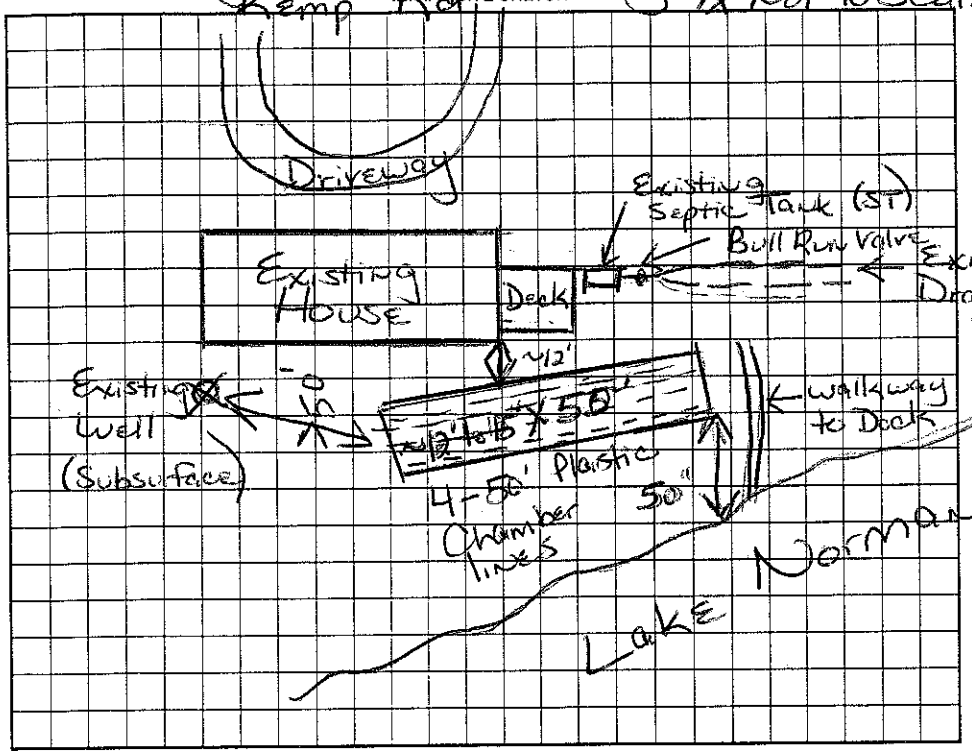

AS BUILT SKETCH

Installed bed of "Plastic Chambers" 4-50' lines

Permit can be suspended or revoked if any false information is supplied toward securing the permit/any unauthorized changes are made to the site/any unauthorized changes are made in the installation of the system. Improvement Permit with plat valid without expiration. Improvement Permit with site plan valid for sixty months. Authorization to Construct is valid for a period equal to that of Improvement Permit – not to exceed sixty months.

Signed: Enrico D. Lasitter date 3-8-2007 Installed by: Wayne Clontz

Improvement Permit by: Maria H. Dotson RS date 3/8/2007 Operation Permit by: Maria H. Dotson RS date 4/10/2007

Authorization to Construct by: Maria H. Dotson RS date 3/8/2007 Existing System Inspection by: date

HEALTH DEPT. COPY: WHITE OWNER COPY (FINAL): YELLOW OWNER COPY (INITIAL): PINK