F.S. Ervin Fax 663-5870

IREDELL COUNTY HEALTH DEPARTMENT

STATESVILLE 704-878-5305 MOORESVILLE 704-664-5281

IMPROVEMENT PERMIT / AUTHORIZATION TO CONSTRUCT / OPERATION PERMIT / EXISTING SYSTEM INSPECTION

PERMIT# 11858-2 PIN# 4626384001.308 4626174895 DATE 12/30/04

OWNER OR CONTRACTOR THE FARMS I, L.C. / KERRY CONSTRUCTION PHONE: Business _____ Home _____

ADDRESS 2214 BRAWLEY SCHOOL RD. MOORESVILLE NC 28115

LOCATION BRAWLEY SCHOOL - TR McKENDREE - TAMARRON - TR BAYBERRY - ON RT

SUBDIVISION THE FARMS BLOCK / SECTION 3 LOT 308 LOT AREA 1.42AC SITE CLASS. CS DESIGN FLOW 450GPD L.T.A.R. .36GPD/FT²

Septic Tank: ~~1000~~ 1500 Gallons; STB 328 Date 5-21-06

Pump Tank: _____ Gallons; PT _____ Date _____

Pump Make: _____ Model _____ Serial No. _____

Nitrification Field: No Fields 1 Square Feet 1000 Linear Feet 400

No Lines 3@133' Trench Width 36" Max Trench Bottom Depth 36" Gravel Depth N/A

☐ New System ☐ Repair System Type: I, II, III, IV, V, VI

System Description: C.A. w/ 25% REDUCTION

Repair System Description: SAME

Maintenance Agreement Required: ☐ Yes ☒ No

☒ House/Mod. Home No. Bedrooms 4

☐ Mobile Home No. Bathrooms 4

☐ Business No. Employees ____

☐ Other _____

☐ Slab ☐ Crawl Space ☐ Basement w/plumbing ☐ Basement wo/plumbing


Water Supply: ☐ Individual ☐ Public ☒ Community

Comments:/Conditions:


Comments:/Conditions:

Blue Poly lok filter Quick-4 installed as per initial site sketch except for tank-moved to 5' off deck as corrected on site sketch

1"=50' INITIAL SITE SKETCH

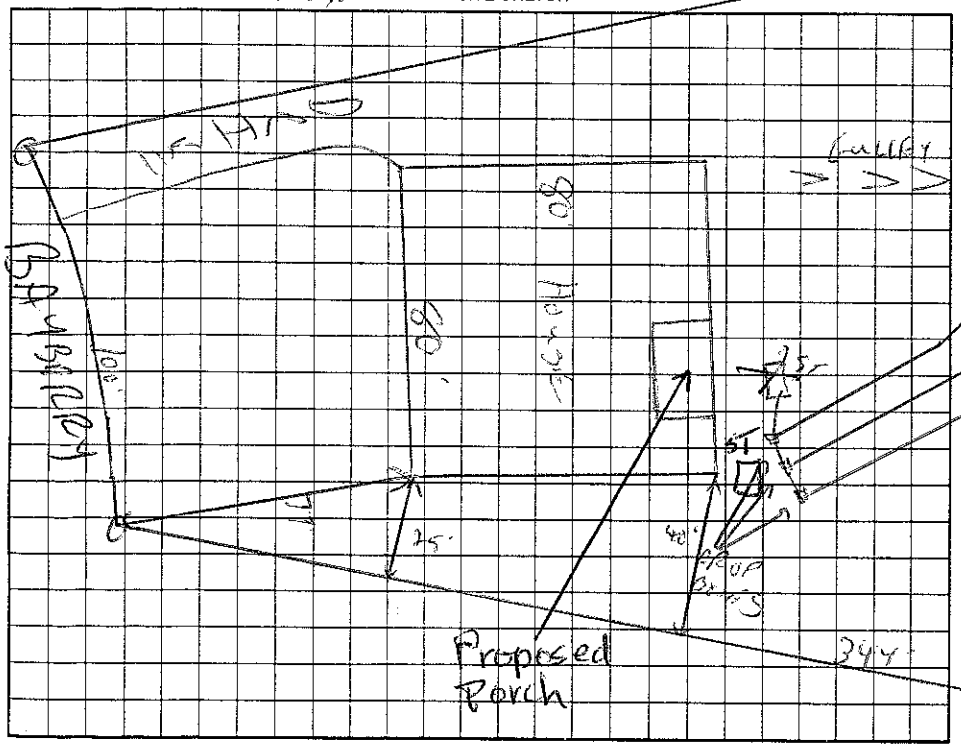

AS BUILT SKETCH

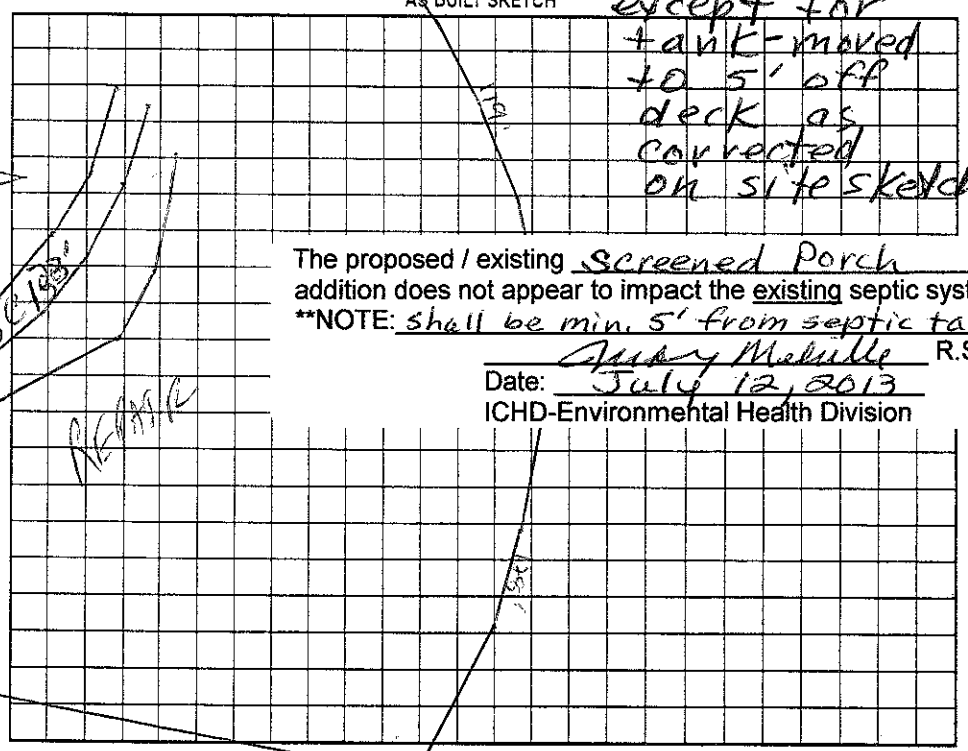

The proposed / existing Screened Porch addition does not appear to impact the existing septic system.

**NOTE: shall be min. 5' from septic tank

Judy Melville R.S.

Date: July 12, 2013

ICHD-Environmental Health Division

Permit can be suspended or revoked if any false information is supplied toward securing the permit/any unauthorized changes are made to the site/any unauthorized changes are made in the installation of the system. Improvement Permit with plat valid without expiration. Improvement Permit with site plan valid for sixty months. Authorization to Construct is valid for a period equal to that of Improvement Permit – not to exceed sixty months.

Signed: _____ date 2-24-05 Installed by: F.S. Ervin

Improvement Permit by: C. _____ RS date 12/30/04 Operation Permit by: Judy Melville date 8-8-06

Authorization to Construct by: Wally Sparks RS. date 12/2/05 Existing System Inspection by: _____ date _____

HEALTH DEPT. COPY: WHITE OWNER COPY (FINAL): YELLOW OWNER COPY (INITIAL): PINK