IREDELL COUNTY HEALTH DEPARTMENT

STATESVILLE 704-878-5305 MOORESVILLE 704-664-5281

IMPROVEMENT PERMIT / AUTHORIZATION TO CONSTRUCT / OPERATION PERMIT / EXISTING SYSTEM INSPECTION

PERMIT# 118584 PIN# 4626 38 4001.309 4626176945 DATE 1/3/05

OWNER OR CONTRACTOR THE FARMS LLC / ESTJOHNSON BLDRS. PHONE: Business Home

ADDRESS 7214 BRAWLEY SCHOOL RD MOORESVILLE NC 28115

LOCATION BRAWLEY SCHOOL - TR MCKENDREE - ~~MCKENDREE~~ - TR BAYBERRY - ON RT

SUBDIVISION THE FARMS BLOCK / SECTION 3 LOT 309 LOT AREA 1.04AC SITE CLASS. PS DESIGN FLOW 450GPD L.T.A.R. .3600 ft²

Septic Tank: 1000 Gallons; STB Date

Pump Tank: Gallons; PT Date

Pump Make: Model Serial No.

Nitrification Field: No Fields 1 Square Feet 1200 Linear Feet 400

No Lines 4@100' Trench Width 36" Max Trench Bottom Depth 36" Gravel Depth N/A

☑ New System ☐ Repair System Type: I, II, III, IV, V, VI

System Description: 60A'S 25% REDUCTION

Repair System Description: LE PANEL

Maintenance Agreement Required: ☐ Yes ☑ No

☑ House/Mod. Home No. Bedrooms 4

☐ Mobile Home No. Bathrooms 4

☐ Business No. Employees

☐ Other


☐ Slab ☑ Crawl Space ☐ Basement w/plumbing ☐ Basement wo/plumbing

Water Supply: ☐ Individual ☑ Public ☑ Community


Comments/Conditions: 1/17/06 CV - Okay to use Distribution box

Comments/Conditions: Checked ST & 3 of 4 lines 2/2/06

INITIAL SITE SKETCH 1"=50'

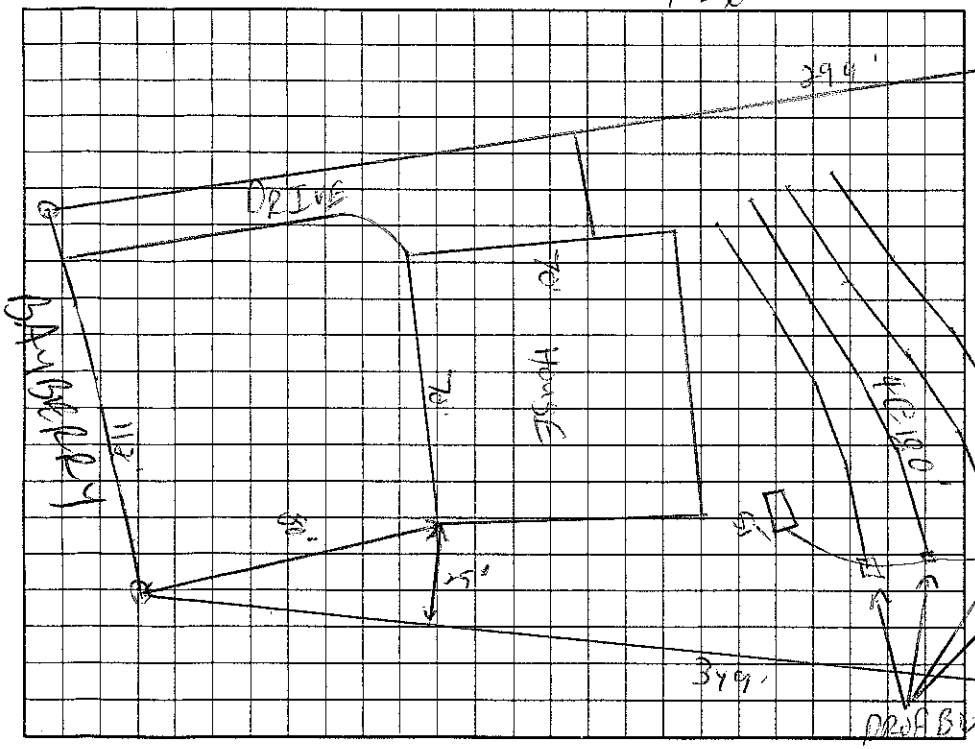

AS BUILT SKETCH

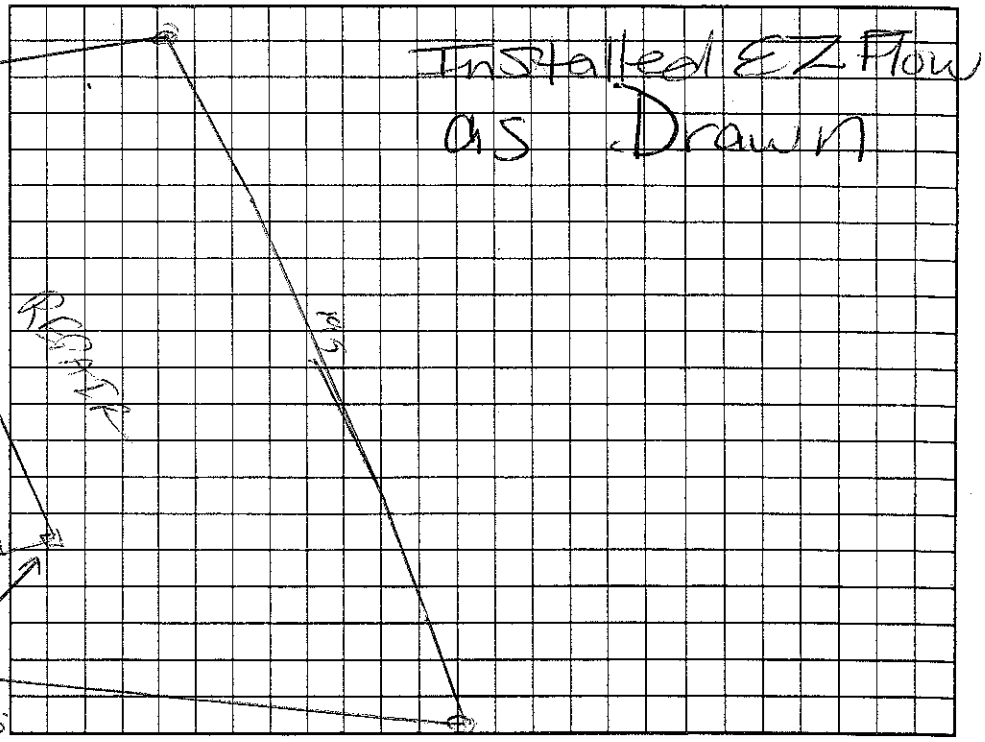

Permit can be suspended or revoked if any false information is supplied toward securing the permit/any unauthorized changes are made to the site/any unauthorized changes are made in the installation of the system. Improvement Permit ~~with plat valid~~ without ~~expiration~~. Improvement Permit with site plan valid for sixty months. Authorization to Construct is valid for a period equal to that of Improvement Permit - not to exceed sixty months.

Signed: date 2-24-05 Installed by: Willie Christenbury RS

Improvement Permit by: date 1/3/05 Operation Permit by: date 2/28/06

Authorization to Construct by: date 1/26/05 Existing System Inspection by: date

HEALTH DEPT. COPY: WHITE OWNER COPY (FINAL): YELLOW OWNER COPY (INITIAL): PINK