IREDELL COUNTY HEALTH DEPARTMENT

STATESVILLE 704-878-5305 MOORESVILLE 704-664-5281

3

IMPROVEMENT PERMIT / AUTHORIZATION TO CONSTRUCT / OPERATION PERMIT / EXISTING SYSTEM INSPECTION

PERMIT # 131277 PIN # 4626-18-0919 (SFE 4626-18-1744) DATE 11-20-09

OWNER or APPLICANT GREG & BONNIE BATTALIA PHONE: Business 704-526-6851 Home:

OWNER or APPLICANT ADDRESS PO BOX 5159 STATESVILLE, NC 28687

LOCATION / DIRECTIONS BSR, TR MCKENDREE, JR BAREFOOT, TR E. COLD HOLLOW FARMS, 1ST ON L

SUBDIVISION THE FARMS BLOCK / SECTION 4 LOT # 484 LOT AREA .895AC SFE-5.58 AC DESIGN FLOW 600 GPD L.T.A.R. .75

Septic Tank X 1500 Gallons: STB B 444 Date 9-1-10

Pump Tank X 1500 Gallons: P T 477 Date 5-15-10

Pump Make Goulds Model WE10 12HU Serial #

Nitrification Field No Fields 1 No Lines 5 Linear Feet 400'

Trench Width 24-36" Max. Trench Bottom Depth 36" Gravel Depth SAND ☐ GRAVITY ☒ PRESSURE

☒ New System ☐ Repair ☐ Expansion System Type I II III (IV) V VI

System Description: LP- PANEL BLOCK (SFE)

Repair System Description: LP- PANEL BLOCK (SFE)

Maintenance Agreement Required ☒ YES ☐ NO


☒ Residence No. Bedrooms 5 ☐ Business No. Persons ☐ Other No. Employees ☐ Slab ☐ Crawl Space ☒ Basement w/plumbing ☐ Basement w/o plumbing

Water Supply: ☐ Private ☐ Public ☒ Community

Comments / Conditions 1) INSTALL ON CONTOUR 2) 18 PANELS PER LINE 3) INITIAL SYSTEM CAN BE MOVED FORWARD IF DESIRED BUT NO CLOSER THAN 15' FROM EDGE OF GULLY

Comments / Conditions 6/7/2010 Reviewed floor plans in compliance with Improvement Permit. Doorway on playroom must be "arched."


INITIAL SITE SKETCH

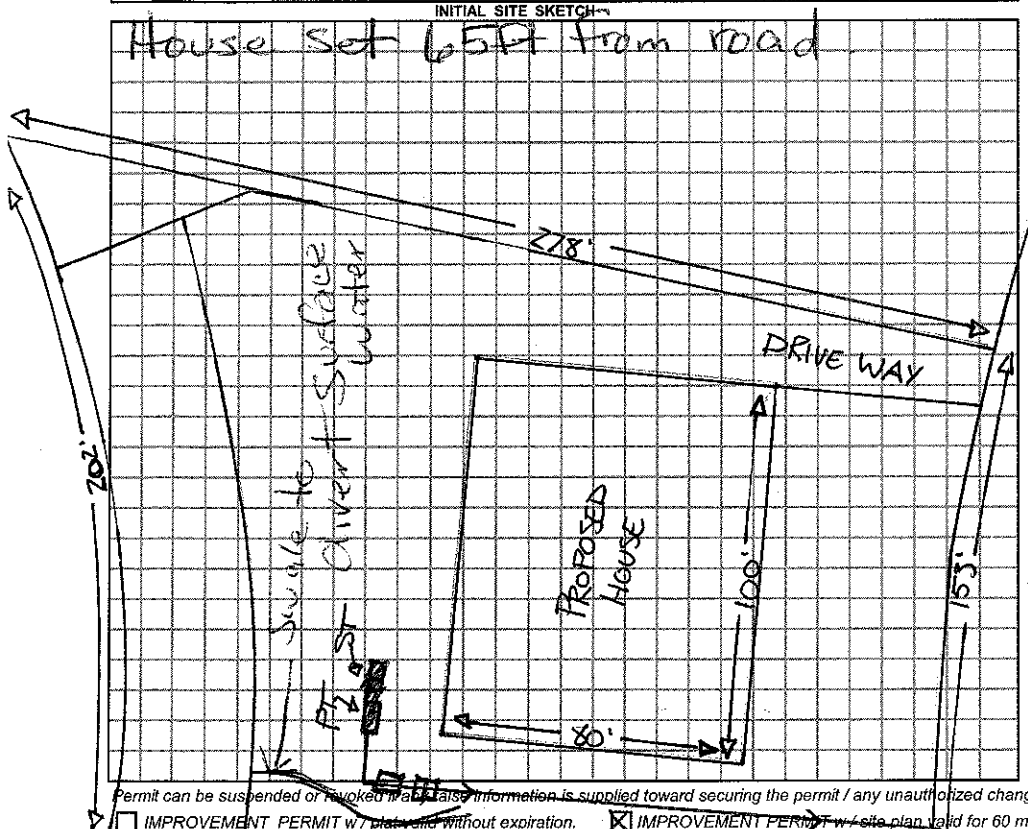

AS BUILT SKETCH

11/3/2010 Checked PTs top line

11/9/2010 Drainfield Valve Box & Pressure checked by EA

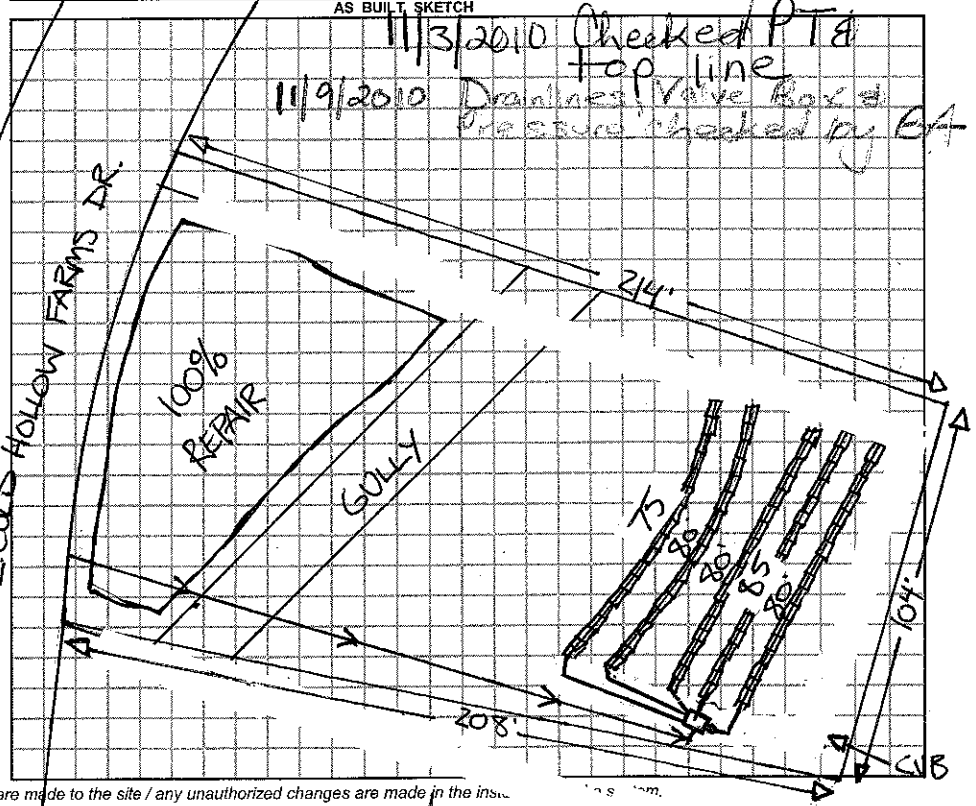

Permit can be suspended or revoked if false information is supplied toward securing the permit / any unauthorized changes are made to the site / any unauthorized changes are made in the inst... / ...not to exceed 60 mo.

☐ IMPROVEMENT PERMIT w/ plat valid without expiration. ☒ IMPROVEMENT PERMIT w/ site plan valid for 60 mos. ☐ AUTHORIZATION TO CONSTRUCT valid for period equal to Im...

Owner / Applicant Signature: [signature] 11/20/09 Date

Improvement Permit by: [signature] REHS Date 11-20-09

Authorization to Construct by: [signature] REHS Date 6/7/2010

Installed by: Richard Abernathy REHS

Operation Permit by: [signature] Date: 2/11/2011

Existing System Inspected by: Date:

YOU SHOULD CONTACT A LOCATOR SERVICE PRIOR TO ANY EXCAVATION.

WHITE COPY Environmental Health YELLOW COPY (Final) Owner / Applicant PINK COPY (Initial) Owner / Applicant