IREDELL COUNTY HEALTH DEPARTMENT

STATESVILLE 704-878-5305 (1) MOORESVILLE 704-664-5281

IMPROVEMENT PERMIT / AUTHORIZATION TO CONSTRUCT / OPERATION PERMIT / EXISTING SYSTEM INSPECTION

PERMIT # 160741 PIN # 4626182508 DATE May 7, 2010

OWNER or APPLICANT Michael & Krista Mooney PHONE: Business 704-361-9499 Home: 704-658-9713

OWNER or APPLICANT ADDRESS 108 Bare Foot Lane Mooresville NC 28117

LOCATION / DIRECTIONS Brawley Sch. Rd. TR McKendree TR Bare Foot on right

SUBDIVISION The Farms BLOCK / SECTION 4 LOT # 502 LOT AREA .749Ac DESIGN FLOW 480gpd L.T.A.R.

Septic Tank Existing Gallons: STB Date

Pump Tank Existing Gallons: P T Date

Pump Make Model Serial #

Nitrification Field No Fields 1 No Lines Linear Feet

Trench Width Max. Trench Bottom Depth Gravel Depth

☐ New System ☐ Repair ☐ Expansion System Type I II III (IV) V VI

System Description: LP PPBPS Existing

Repair System Description: LP PPBPS

Maintenance Agreement Required ☒ YES ☐ NO

☐ GRAVITY ☒ PRESSURE

☒ Residence No. Bedrooms 4

☐ Business No. Persons

☐ Other No. Employees

☐ Slab ☒ Crawl Space

☐ Basement w/plumbing ☐ Basement w/o plumbing

Water Supply: ☐ Private ☐ Public ☒ Community

Comments / Conditions


Comments / Conditions original operation Permit Issued 11-3-06; Permit #131325

Required:

Minimum distance from any building foundation to drain line: 5'

INITIAL SITE SKETCH

AS BUILT SKETCH

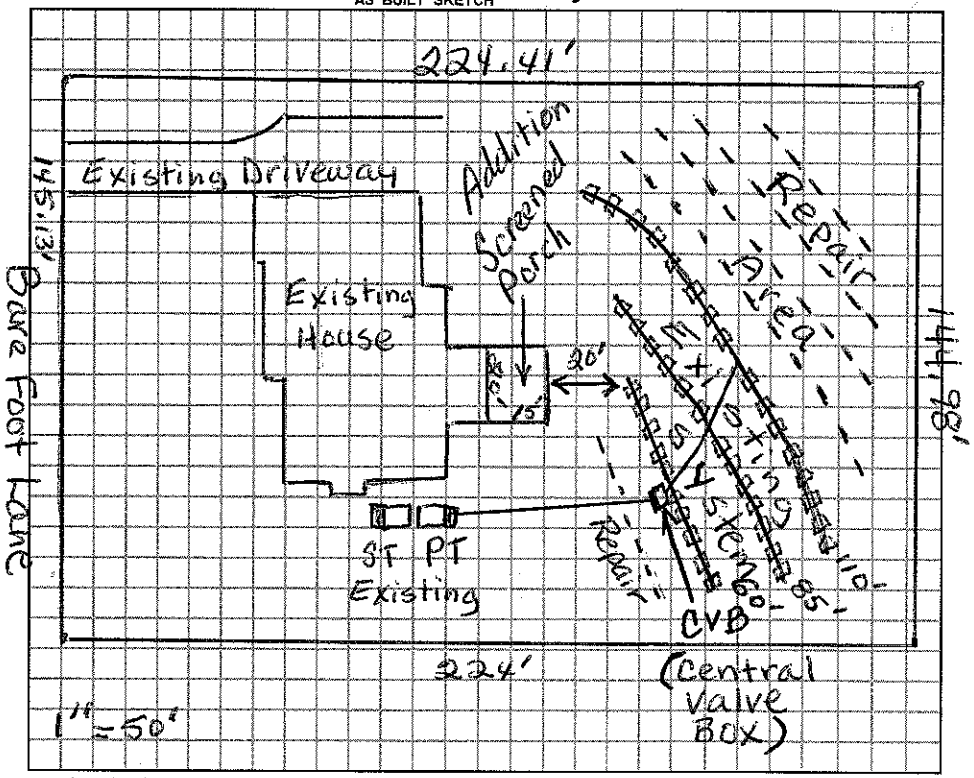

Permit can be suspended or revoked if any false information is supplied toward securing the permit / any unauthorized changes are made to the site / any unauthorized changes are made in the installation of the system.

☐ *IMPROVEMENT PERMIT w / plat valid without expiration.* ☐ *IMPROVEMENT PERMIT w / site plan valid for 60 mos.* ☐ *AUTHORIZATION TO CONSTRUCT valid for period equal to IMPROVEMENT PERMIT-not to exceed 60 mo.*

Owner / Applicant Signature: Krista Mooney Date 5-10-10

Improvement Permit by: Date

Authorzation to Construct by: Date

YOU SHOULD CONTACT A LOCATOR SERVICE PRIOR TO ANY EXCAVATION.

Installed by:

Operation Permit by: Date:

Existing System Inspected by: Date: 5-7-10

WHITE COPY Environmental Health YELLOW COPY (Final) Owner / Applicant PINK COPY (Initial) Owner / Applicant