IREDELL COUNTY HEALTH DEPARTMENT

STATESVILLE 704-878-5305 MOORESVILLE 704-664-5281

IMPROVEMENT PERMIT / AUTHORIZATION TO CONSTRUCT / OPERATION PERMIT / EXISTING SYSTEM INSPECTION

PERMIT # 159670 PIN # 4626 183 728 DATE 1-27-2010

OWNER or APPLICANT Jerilyn & Bill McDade PHONE: Business (704) 715-9224 Home: 704 664 2553

OWNER or APPLICANT ADDRESS 118 E Cold Hollow Farm Dr. Mooresville NC 28117

LOCATION / DIRECTIONS Brawley School Rd TR McKendree TR Barefoot TR E Cold Hollow lot on right

SUBDIVISION The Farms BLOCK / SECTION LOT # 500 LOT AREA 1.269Ac DESIGN FLOW 480gpd L.T.A.R. .275

Septic Tank 1500 Gallons: STB Date

Pump Tank Gallons: PT Date

Pump Make Model Serial #

Nitrification Field No Fields 2 No Lines 6 Linear Feet 444

Trench Width 36" Max. Trench Bottom Depth 36" Gravel Depth N/A

☒ New System ☐ Repair ☐ Expansion System Type I II III IV V VI

System Description: Gravity - 25% Reduction

Repair System Description: Pump - Panel BIK

Maintenance Agreement Required ☒ YES ☐ NO

☒ GRAVITY ☐ PRESSURE

☒ Residence No. Bedrooms 4

☐ Business No. Persons

☐ Other No. Employees

☐ Slab ☐ Crawl Space

☐ Basement w/plumbing ☐ Basement w/o plumbing


Water Supply: ☐ Private ☒ Public ☐ Community

Comments / Conditions: Existing System appears to be Functioning okay at time of inspection.


Comments / Conditions: Porch addition should not impact Septic System.

☒ Septic System installed & O.P. issued 8-1-2007

INITIAL SITE SKETCH

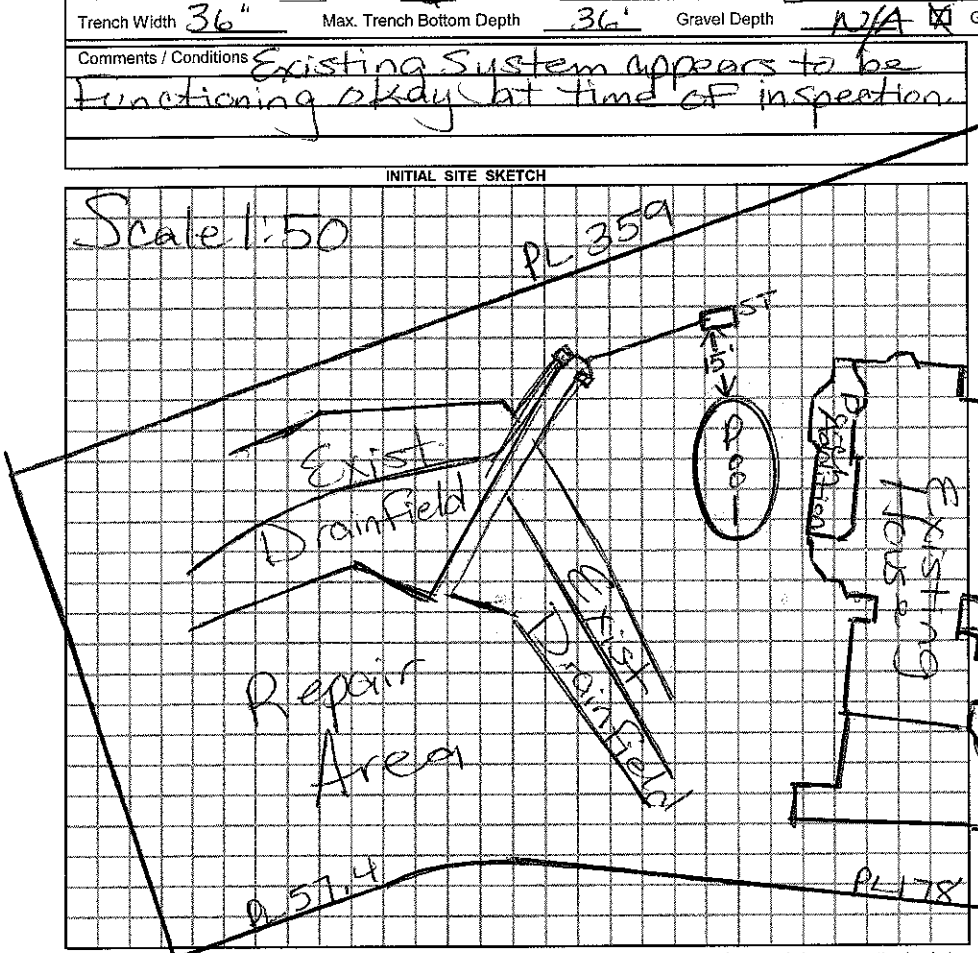

AS BUILT SKETCH

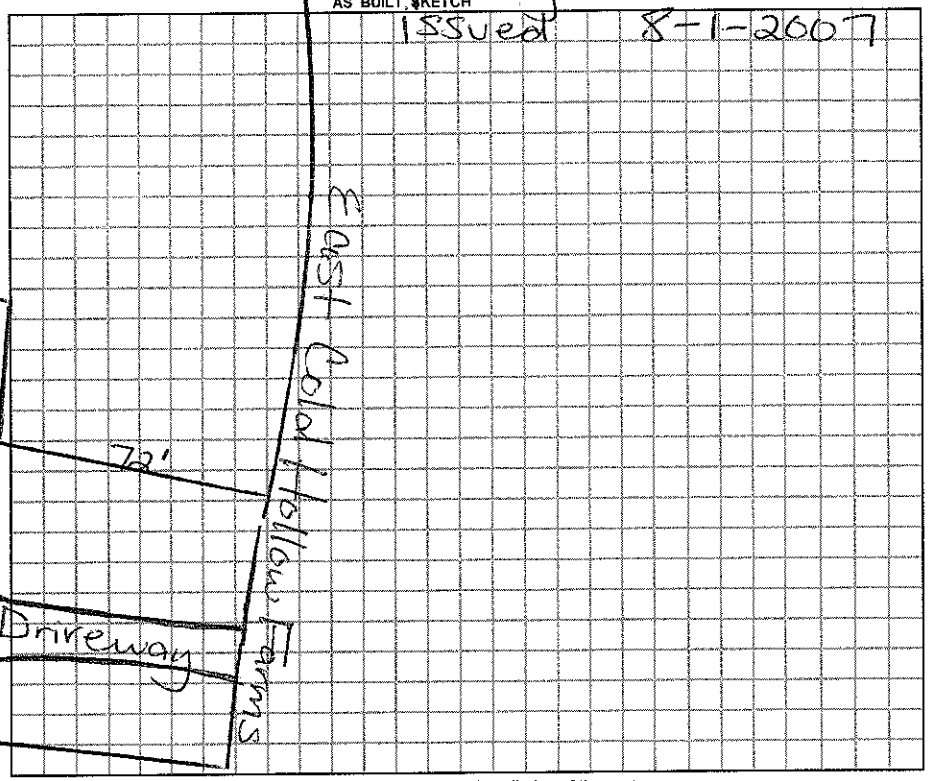

Permit can be suspended or revoked if any false information is supplied toward securing the permit / any unauthorized changes are made to the site / any unauthorized changes are made in the installation of the system.

☐ *IMPROVEMENT PERMIT w / plat valid without expiration.* ☒ *IMPROVEMENT PERMIT w / site plan valid for 60mos.* ☐ *AUTHORIZATION TO CONSTRUCT valid for period equal to IMPROVEMENT PERMIT-not to exceed 60 mo.*

Owner / Applicant Signature: Bill McDade Date 1/28/10

Improvement Permit by: Date

Authorzation to Construct by: Date

Installed by:

Operation Permit by: Date

Existing System Inspected by: Date: 1/27/2010

YOU SHOULD CONTACT A LOCATOR SERVICE PRIOR TO ANY EXCAVATION.

WHITE COPY Environmental Health YELLOW COPY (Final) Owner / Applicant PINK COPY (Initial) Owner / Applicant