IREDELL COUNTY HEALTH DEPARTMENT

Statesville Office (704) 878-5305 Mooresville Office (704) 660-3625 PERMIT # 211329

IMPROVEMENT PERMIT / AUTHORIZATION TO CONSTRUCT / OPERATION PERMIT / EXISTING SYSTEM

PIN # 4626-18-4382

APPLICANT: RUDY DIPIETRO APPLICANT ADDRESS: WESTBROOK, MAINE


SITE DIRECTIONS: BSR, TR MCKENDREE, TL BAYBERRY, ON L

SUBDIVISION: THE FARMS SECTION: 3 LOT # 443 LOT AREA: 1.045 AC DESIGN FLOW: L.T.A.R.:

Septic Tank ____ (gal) STB ____ Date ____
Pump Tank 5 (gal) PT ____ Date ____
Pump Make ____ Model ____ Serial # ____
Nitrification Fields 5 X 1 # Lines 7 N G Linear Ft: ____
Trench Width ____ Max. Trench Bottom Depth ____ Gravel Depth —

☐ New System ☐ Repair ☐ Expansion System Type: I II III IV V VI
System Description: 25% REDUCTION
Repair System Description: PANEL BLOCK
Maintenance Agreement Required: ☐ YES ☒ NO
☑ GRAVITY ☐ PRESSURE

☐ Residence No. Bedrooms ____
☐ Business No. Persons ____
☒ Other No. Employees ____
☐ Slab ☐ Crawl Space
☐ Basement w/plumbing ☐ Basement w/o plumbing

Water Supply
☐ Private
☐ Public
☑ Community

Comments / Conditions:

POOL

INITIAL SITE SKETCH

SEE PLAN FROM PENNINGER SOIL CONSULTING

AS BUILT SKETCH

Permit can be suspended or revoked if any false information is supplied toward securing the permit / any unauthorized changes are made to the site / any unauthorized changes are made in the installation of the system. **CONTACT A LOCATOR SERVICE PRIOR TO ANY EXCAVATION**


☐ **IMPROVEMENT PERMIT** *with plat valid without expiration.* ☐ **IMPROVEMENT PERMIT** *with site plan valid for 60 mos.* ☐ **AUTHORIZATION TO CONSTRUCT** *valid for period equal to IMPROVEMENT PERMIT--not to exceed 60 mo.*

Owner / Applicant Signature: [signature] Date: 6-26-15 Installed by: ____

IMPROVEMENT PERMIT by: ____ Date: ____ OPERATION PERMIT by: ____ Date: ____

AUTHORIZATION TO CONSTRUCT by: ____ Date: ____ Existing System Inspected by: [signature] Date: APPROVED JUN 23 2015

Health Dept. Copy - WHITE Applicant (Final Approval) - YELLOW Applicant (Conditional Approval) - PINK

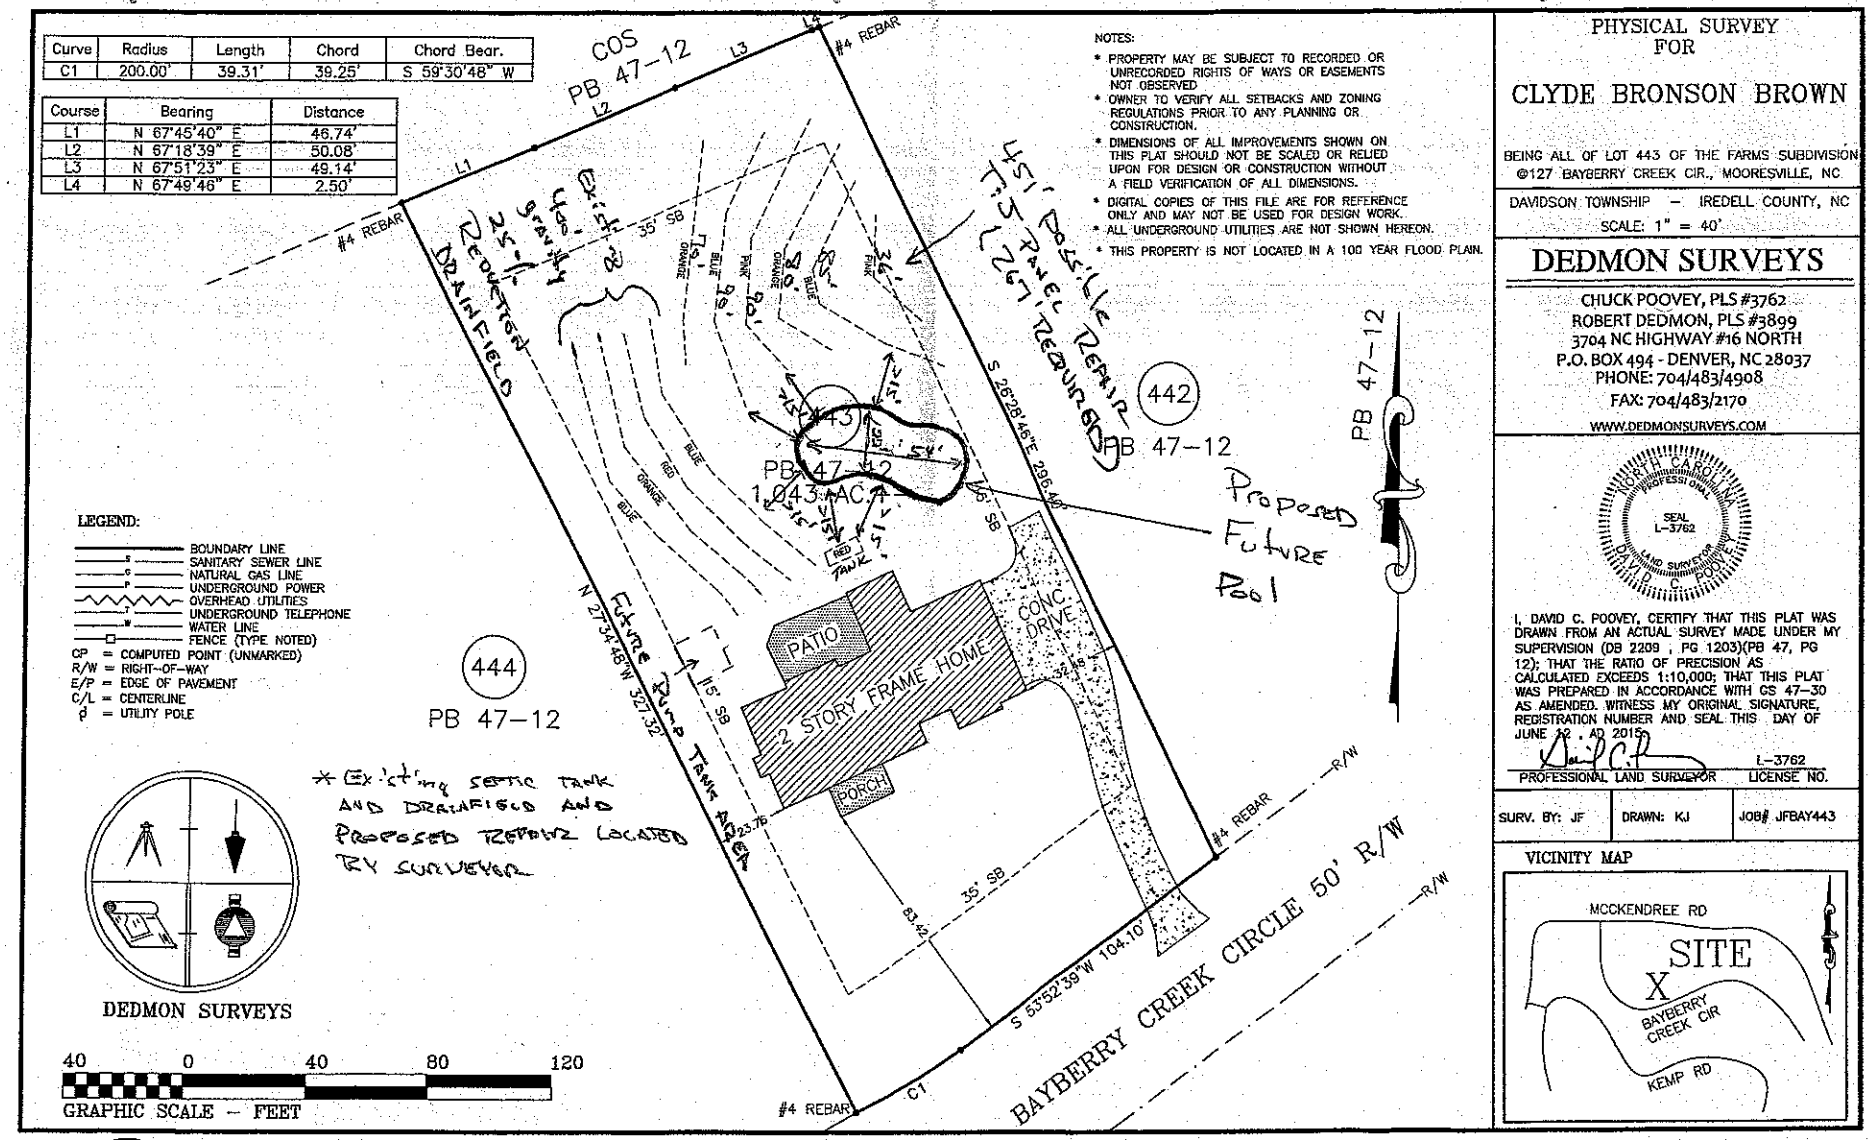

Rudy Dipietro Existing System Check For Future Pool 6-17-15
The Farms Lot 443 - 127 Bayberry Cir.