IREDELL COUNTY HEALTH DEPARTMENT

STATESVILLE 704-878-5305 MOORESVILLE 704-664-5281

IMPROVEMENT PERMIT / AUTHORIZATION TO CONSTRUCT / OPERATION PERMIT / EXISTING SYSTEM INSPECTION

1:00 375

PERMIT# 11967G PIN# ~~4625505744.442~~ 4620186317 DATE 1/3/05

OWNER OR CONTRACTOR THE FARMS LLC / Stone bridge PHONE: Business Home

ADDRESS 2214 BRAWLEY SCHOOL RD / MOORESVILLE NC 28115

LOCATION BRAWLEY SCHOOL - TR McKENDREE - ~~TR~~ TR BAYBERRY - ON LT

SUBDIVISION THE FARMS BLOCK / SECTION 3 LOT 44 LOT AREA .88Ac SITE CLASS. RS DESIGN FLOW 450GD L.T.A.R. .360/A-2

Septic Tank: 1000 Gallons; STB 525 Date 4-30-07

Pump Tank: 1000 Gallons; PT 17 Date 6-26-07

Pump Make Goulds Model WE0512HC Serial No. 307580G2

Nitrification Field: No Fields 1 Square Feet 540 Linear Feet 270

No Lines 3@90' Trench Width 24" Max Trench Bottom Depth 36" Gravel Depth NR

☑ New System ☐ Repair System Type: I, II, III, (IV), V, VI

System Description: LE PANEL

~~Repair System Description:~~ SAME

Maintenance Agreement Required: ☑ Yes ☐ No

☑ House/Mod. Home No. Bedrooms 4

☐ Mobile Home No. Bathrooms 4

☐ Business No. Employees

☐ Other


☐ Slab ☑ Crawl Space ☐ Basement w/plumbing ☐ Basement wo/plumbing

Water Supply: ☐ Individual ☐ Public ☑ ~~Community~~


Comments/Conditions: DO NOT CUT HOUSE SITE

Comments/Conditions: 1/27/07 Checked tanks & lines (Installed as Drawn) 2ft pressure set

INITIAL SITE SKETCH 1"=50'

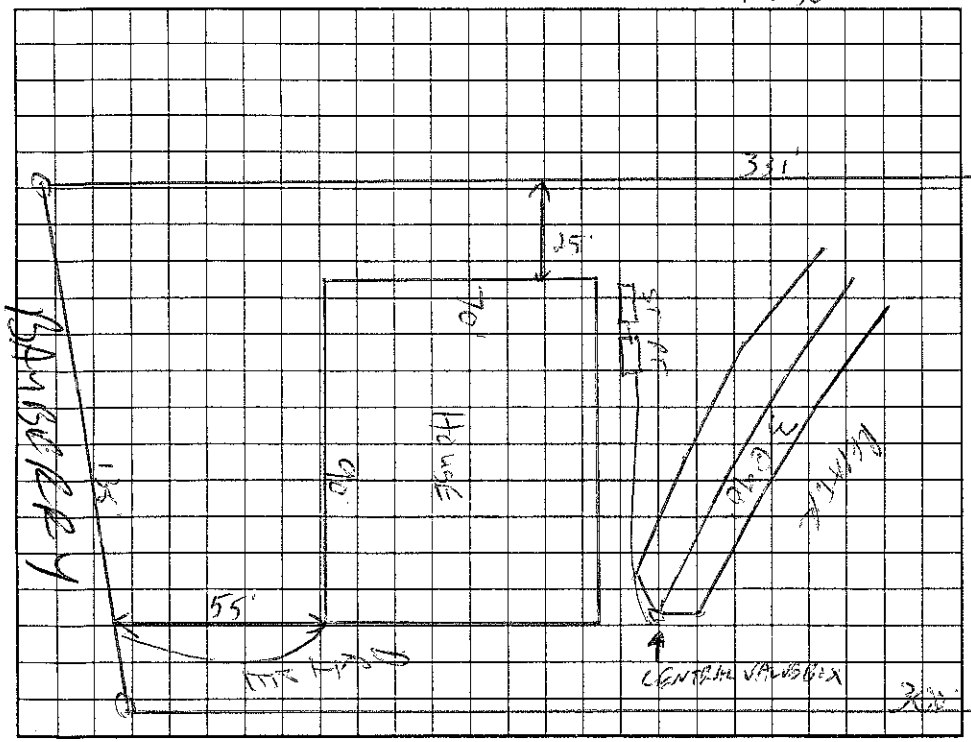

AS BUILT SKETCH

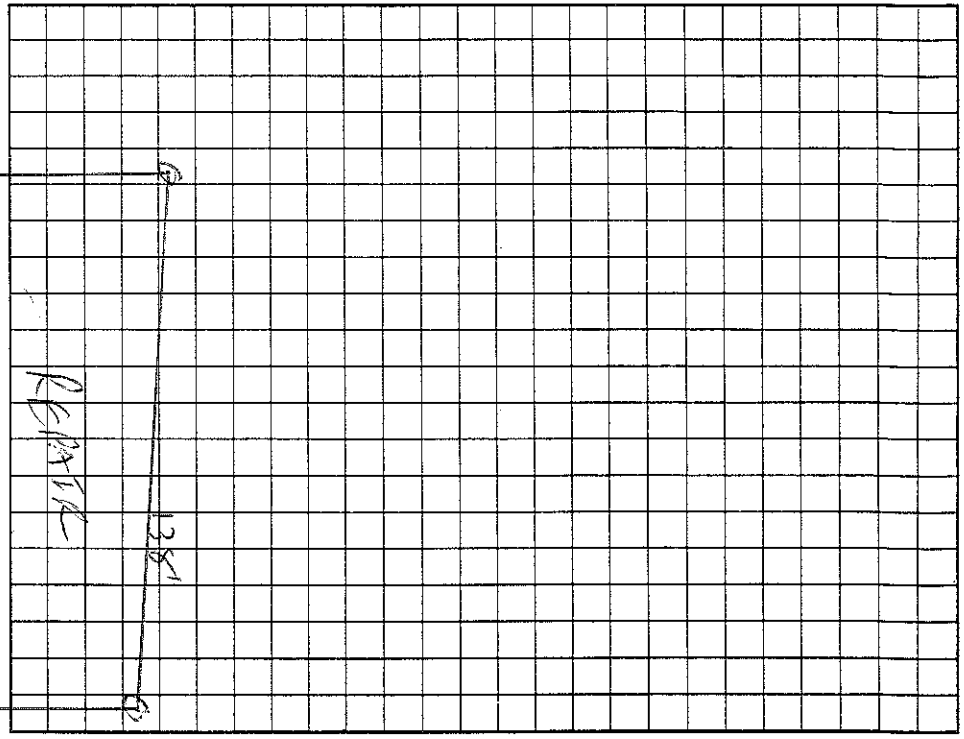

Permit can be suspended or revoked if any false information is supplied toward securing the permit/any unauthorized changes are made to the site/any unauthorized changes are made in the installation of the system. Improvement Permit with plat valid without expiration. Improvement Permit with site plan valid for sixty months. Authorization to Construct is valid for a period equal to that of Improvement Permit – not to exceed sixty months.

Signed: [signature] date 2-24-05 Installed by: Steve Gordon RS

Improvement Permit by: [signature] date 1/3/05 Operation Permit by: [signature] date 1/29/08

Authorization to Construct by: [signature] date 5/30/07 Existing System Inspection by: date

HEALTH DEPT. COPY: WHITE OWNER COPY (FINAL): YELLOW OWNER COPY (INITIAL): PINK