IREDELL COUNTY HEALTH DEPARTMENT

Mark Swavely

STATESVILLE 704-878-5305 MOORESVILLE 704-664-5281

130

IMPROVEMENT PERMIT / AUTHORIZATION TO CONSTRUCT / OPERATION PERMIT / EXISTING SYSTEM INSPECTION

PERMIT# 118585 PIN# 4626 38 4001.310 4626-18-7067 DATE 2/3/05

OWNER OR CONTRACTOR THE FARMS LLC / Greg Robbins PHONE: Business _____ Home _____

ADDRESS 7214 BRAWLEY SCHOOL RD - MOORESVILLE NC 28115

LOCATION BRAWLEY SCHOOL - TR MCKENDREE - TR BAMBERRY - ON RT

SUBDIVISION THE FARMS BLOCK / SECTION 3 LOT 310 LOT AREA 1.49c SITE CLASS. PS DESIGN FLOW 480GPD L.T.A.R. .360/Ac

Septic Tank: ~~1000~~ 1500 Gallons; STB 444 Date 1-10-06

Pump Tank: 1000 Gallons; PT 27 Date 9/16/06

Pump Make: ~~Red~~ Goulds Model WE0512HH4 Serial No. M053540G

Nitrification Field: No Fields 1 Square Feet 1200 Linear Feet 400

No Lines 3@133' Trench Width 36" Max Trench Bottom Depth 36" Gravel Depth N/A

☑ New System ☐ Repair System Type: I, II, III, IV, V, VI

System Description: PUMP 25% REDUCTION

Repair System Description: LP PANEL

Maintenance Agreement Required: ☐ Yes ☑ No

☑ House/Mod. Home No. Bedrooms 4

☐ Mobile Home No. Bathrooms 4

☐ Business No. Employees ____

☐ Other ____

☐ Slab ☑ Crawl Space ☐ Basement w/plumbing ☐ Basement wo/plumbing


Water Supply: ☐ Individual ☐ Public ☑ Community

Comments:/Conditions:


Storm Drain along PL 1"=50' 294'

Comments:/Conditions: 9/26/05 Reviewed Building plans & Site plan, essentially in Compliance with I.P.

INITIAL SITE SKETCH

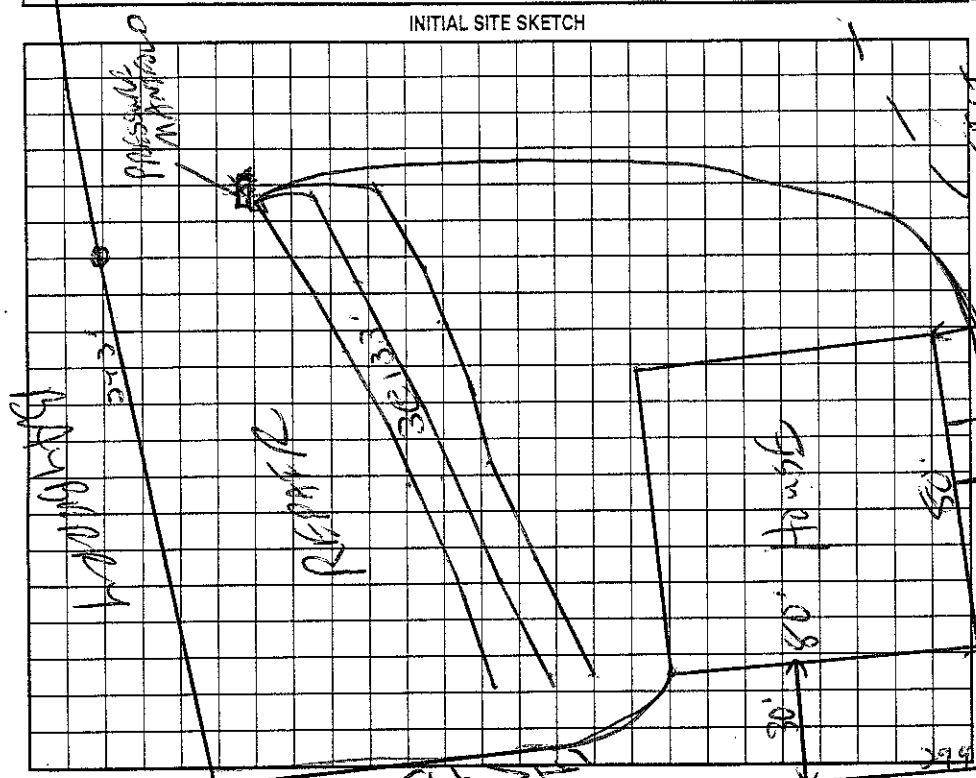

AS BUILT SKETCH

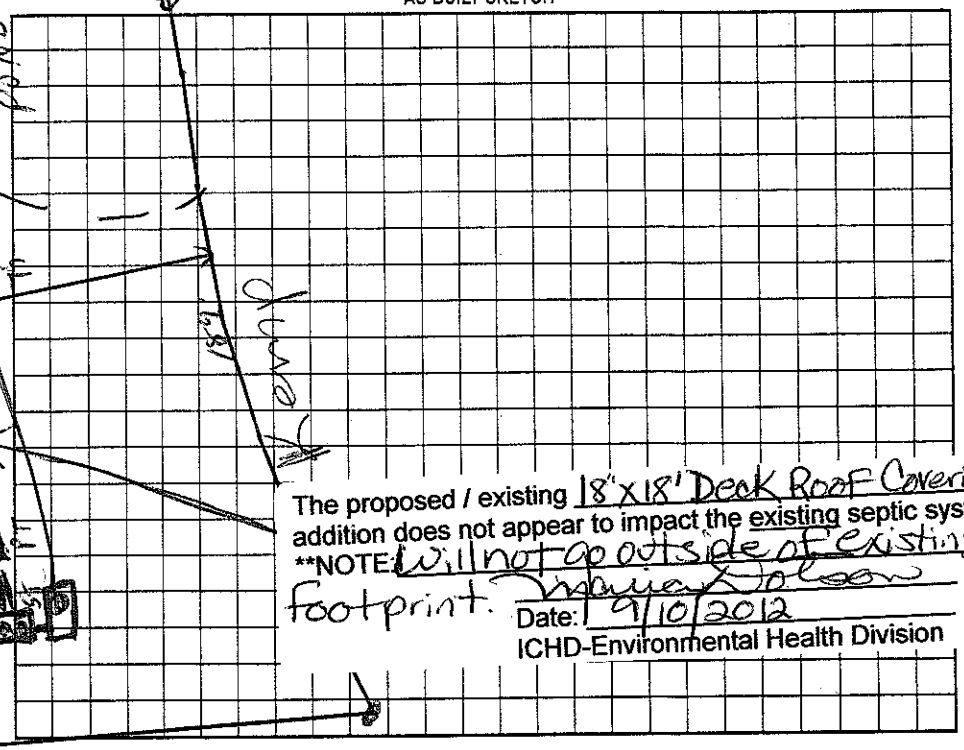

The proposed / existing 18'x18' Deck Roof Covering addition does not appear to impact the existing septic system.

**NOTE: Will not go outside of existing footprint.

Marian H. Dotson R.S.

Date: 9/10/2012

ICHD-Environmental Health Division

Permit can be suspended or revoked if any false information is supplied toward securing the permit/any unauthorized changes are made to the site/any unauthorized changes are made in the installation of the system. Improvement Permit with plat valid without expiration. Improvement Permit with site plan valid for sixty months. Authorization to Construct is valid for a period equal to that of Improvement Permit – not to exceed sixty months.

Signed: _____ date 2-24-05 Installed by: Hallman

Improvement Permit by: _____ date 2/3/05 Operation Permit by: Wesley Sparks R.S. date 7/27/06

Authorization to Construct by: Marian H. Dotson RS date 9/26/05 Existing System Inspection by: _____ date _____

HEALTH DEPT. COPY: WHITE OWNER COPY (FINAL): YELLOW OWNER COPY (INITIAL): PINK