IREDELL COUNTY HEALTH DEPARTMENT

STATESVILLE 704-878-5305 MOORESVILLE 704-664-5281

IMPROVEMENT PERMIT / AUTHORIZATION TO CONSTRUCT / OPERATION PERMIT / EXISTING SYSTEM INSPECTION

PERMIT# 119673 PIN# 4625-50-5104.440 4626-18-8449 DATE 1/3/05

OWNER OR CONTRACTOR THE FARMS LLC PHONE: Business Home

ADDRESS 2314 BRAWLEY SCHOOL RD. MOORESVILLE, NC

LOCATION BRAWLEY SCHOOL - TR McKENDREE - ~~COLUMBUS~~ - TR BAILEY ON LT

SUBDIVISION THE FARMS BLOCK / SECTION 3 LOT 440 LOT AREA .74AC SITE CLASS RS DESIGN FLOW 480GPD L.T.A.R. .256GPD/FT²

Septic Tank: ~~1000~~ 1500 Gallons; STB 528 Date

Pump Tank: 1000 Gallons; PT 1.7 Date

Pump Make Gavlas Model WEC81.2M Serial No F0L6516H4

Nitrification Field: No Fields 1 Square Feet 640 Linear Feet 320

No Lines 4@40' Trench Width 24" Max Trench Bottom Depth 30" Gravel Depth N/A

☑ New System ☐ Repair System Type: I, II, III, (IV), V, VI

System Description: LP PANEL

Repair System Description: LP PANEL

Maintenance Agreement Required: ☑ Yes ☐ No

☐ Slab ☑ Crawl Space ☐ Basement w/plumbing ☐ Basement wo/plumbing

☑ House/Mod. Home No. Bedrooms 4

☐ Mobile Home No. Bathrooms 4

☐ Business No. Employees


☐ Other

Water Supply: ☐ Individual ☐ Public ☑ Community


Comments:/Conditions: DO NOT CUT HOUSE SITE

Comments:/Conditions: Lines & Tanks checked 7/21/06 GR
3/16" hole drilled
Set @ 2ft head
Pressure, elect & alarm

INITIAL SITE SKETCH 1"=50'

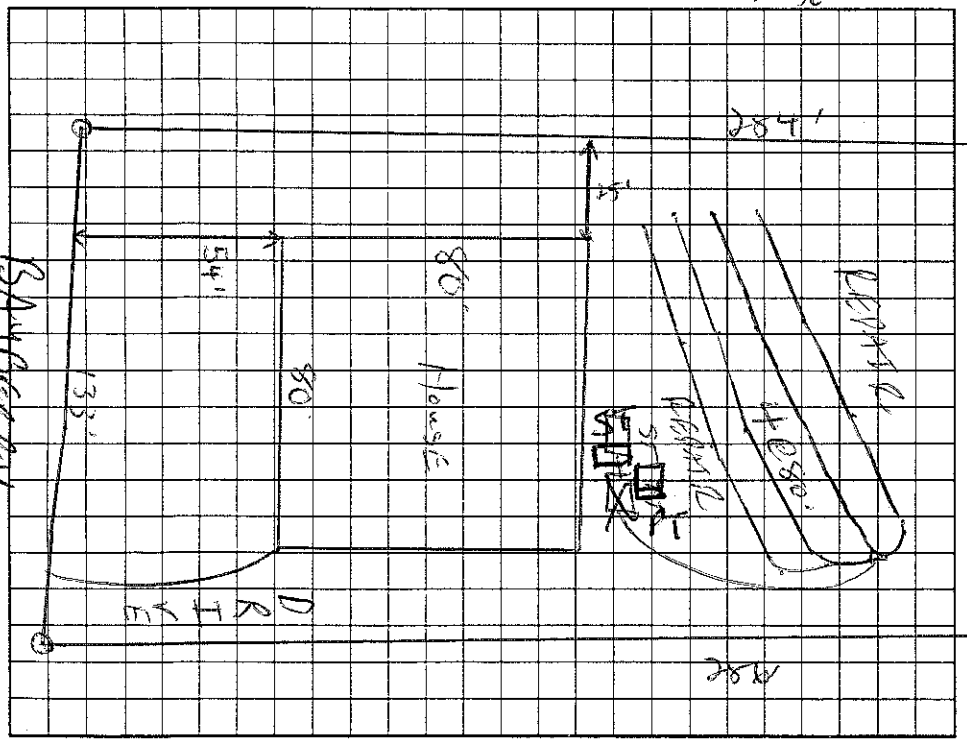

AS BUILT SKETCH

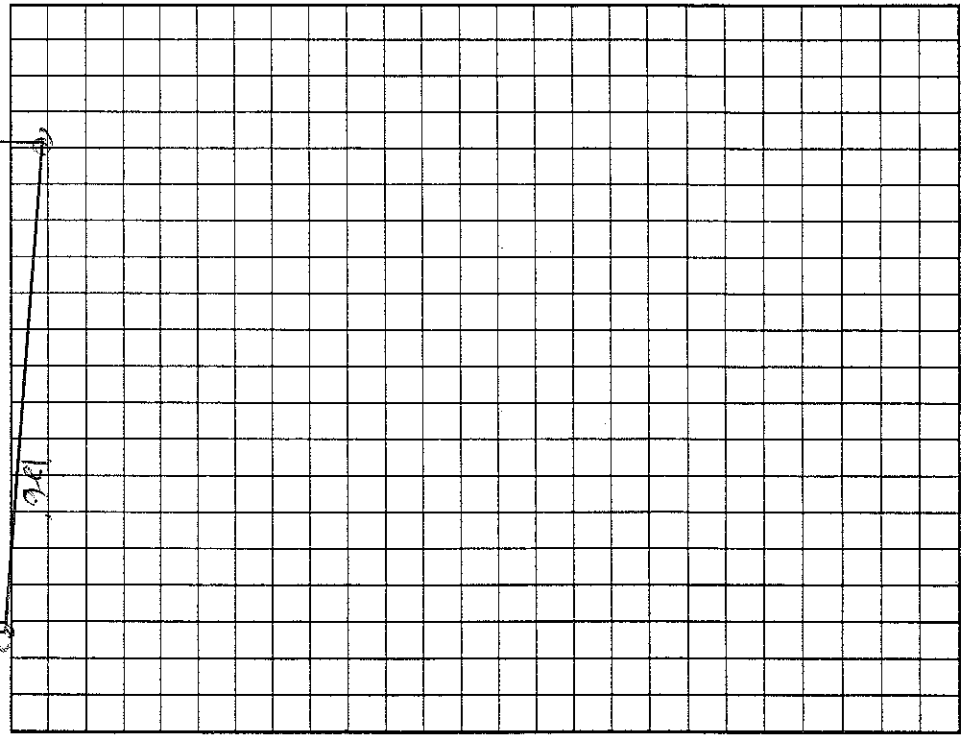

Permit can be suspended or revoked if any false information is supplied toward securing the permit/any unauthorized changes are made to the site/any unauthorized changes are made in the installation of the system. Improvement Permit with plat valid without expiration. Improvement Permit with site plan valid for sixty months. Authorization to Construct is valid for a period equal to that of Improvement Permit – not to exceed sixty months.

Signed: [signature] date 2-24-05 Installed by: Piedmont Backhoe RS

Improvement Permit by: C. Gray EJ date 1/3/05 Operation Permit by: Mariah H. Dolan date 9/27/06

Authorization to Construct by: Judy Merrill date 2-28-06 Existing System Inspection by: date

HEALTH DEPT. COPY: WHITE OWNER COPY (FINAL): YELLOW OWNER COPY (INITIAL): PINK