IREDELL COUNTY HEALTH DEPARTMENT

STATESVILLE 704-878-5305 MOORESVILLE 704-664-5281

IMPROVEMENT PERMIT / AUTHORIZATION TO CONSTRUCT / OPERATION PERMIT / EXISTING SYSTEM INSPECTION

PERMIT# 150642 PIN# 4626190449 DATE 6-6-08

OWNER OR APPLICANT Terrance & Barb Homan PHONE: Business 704-799-6399 Home

ADDRESS 108 Pentland CT Mooresville NC 28117

LOCATION McKeendree, TR Lakeview Shore, TR Pentland, on R

SUBDIVISION CLTT BLOCK / SECTION 8 LOT 262 LOT AREA .61 AC SITE CLASS. PS DESIGN FLOW 360 L.T.A.R. .3

Septic Tank: Existing Gallons: STB Date

Pump Tank: Existing Gallons: PT Date

Pump Make: Model Serial No.

Nitrification Field: No Fields 1 Square Feet 600 Linear Feet 210

No Lines 3@70' Trench Width 36" Max Trench Bottom Depth 36" Gravel Depth — ☐ Gravity ☒ Pressure

☐ New System ☐ Repair ☐ Expansion System Type: I II III IV V VI

System Description: Existing LPPPBPS

Repair System Description: Same

Maintenance Agreement Required: ☒ Yes ☐ No

☒ House/Mod. Home No. Bedrooms 3

☐ Mobile Home No. Persons

☐ Business No. Employees

☐ Other


Water Supply: ☒ Individual ☐ Public ☐ Community

☐ Slab ☒ Crawl Space ☐ Basement w/plumbing ☐ Basement wo/plumbing

Comments:/Conditions:

Comments:/Conditions:

INITIAL SITE SKETCH

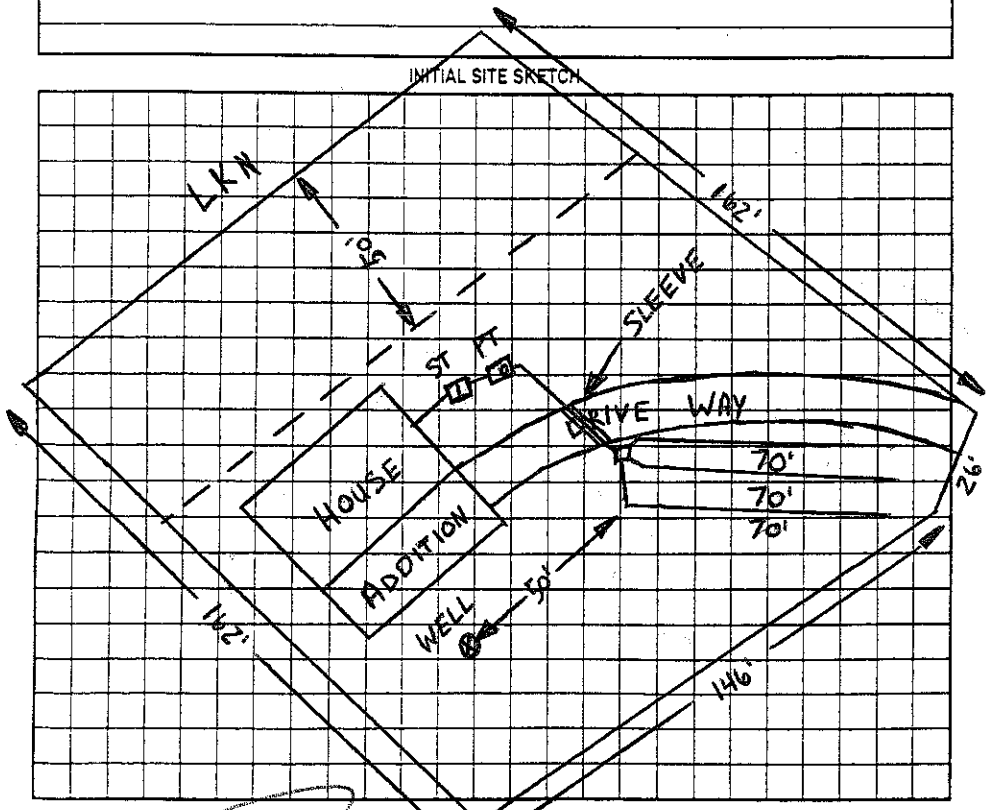

AS BUILT SKETCH

Permit can be suspended or revoked if any false information is supplied toward securing the permit/any unauthorized changes are made to the site/any unauthorized changes are made in the installation of the system. Improvement Permit with plat valid without expiration ☐ Improvement Permit with site plan valid for sixty months ☐ Authorization to Construct is valid for a period equal to that of Improvement Permit – not to exceed sixty months.

Signed: date 6-10-8

Improvement Permit by: date

Authorization to Construct by: date

Installed by:

Operation Permit by: date

Existing System Inspection by: date 6-6-08

HEALTH DEPT. COPY: WHITE OWNER COPY (FINAL): YELLOW OWNER COPY (INITIAL): PINK