2.5

IREDELL COUNTY HEALTH DEPARTMENT

Statesville Office (704) 878-5305 BA Mooresville Office (704) 660-3625 PERMIT # 215511

IMPROVEMENT PERMIT / AUTHORIZATION TO CONSTRUCT / OPERATION PERMIT / EXISTING SYSTEM

PIN # 4626-19-0449.000

APPLICANT: RAYMOND WORKARD APPLICANT ADDRESS: 108 PENTLAND CT. MOORESVILLE NC

SITE ADDRESS: 108 PENTLAND CT. MOORESVILLE NC PHONE: 336-608-0889 ALT. PHONE:

SITE DIRECTIONS: BSR, TR MCKENDREE, TR LAKEVIEW SHORES, TR PENTLAND

SUBDIVISION: CL; T SECTION: 8 LOT # 262 LOT AREA: .560 ACRE DESIGN FLOW: EX 360 GA. T.A.R.: EXISTING

Septic Tank EXISTING (gal) STB Date

Pump Tank EXISTING (gal) PT Date

Pump Make EXISTING Model EX Serial # EX

Nitrification Fields EX # Lines EX. 3 Linear Ft: EX.

Trench Width EX. Max. Trench Bottom Depth EX. Gravel Depth EX.

☐ New System ☐ Repair ☐ Expansion System Type: I II III IV V VI

System Description: EXISTING 3-PATS in Pressure Manifold

Repair System Description: SAME

Maintenance Agreement Required: ☐ YES ☒ NO

☐ GRAVITY ☑ PRESSURE

☑ Residence No. Bedrooms Ex. 3

☐ Business No. Persons Ex. 6

☐ Other No. Employees

☐ Slab ☐ Crawl Space

☒ Basement w/plumbing ☐ Basement w/o plumbing

Water Supply: ☒ Private ☐ Public ☐ Community


Comments / Conditions: MAINTAIN 25' FROM WELL(S) W/ PROPOSED STRUCTURES. SYSTEM APPEARED TO BE FUNCTIONING AT TIME OF INSPECTION.

INITIAL SITE SKETCH

1" = 40'

LAKE NORMAN

AS BUILT SKETCH

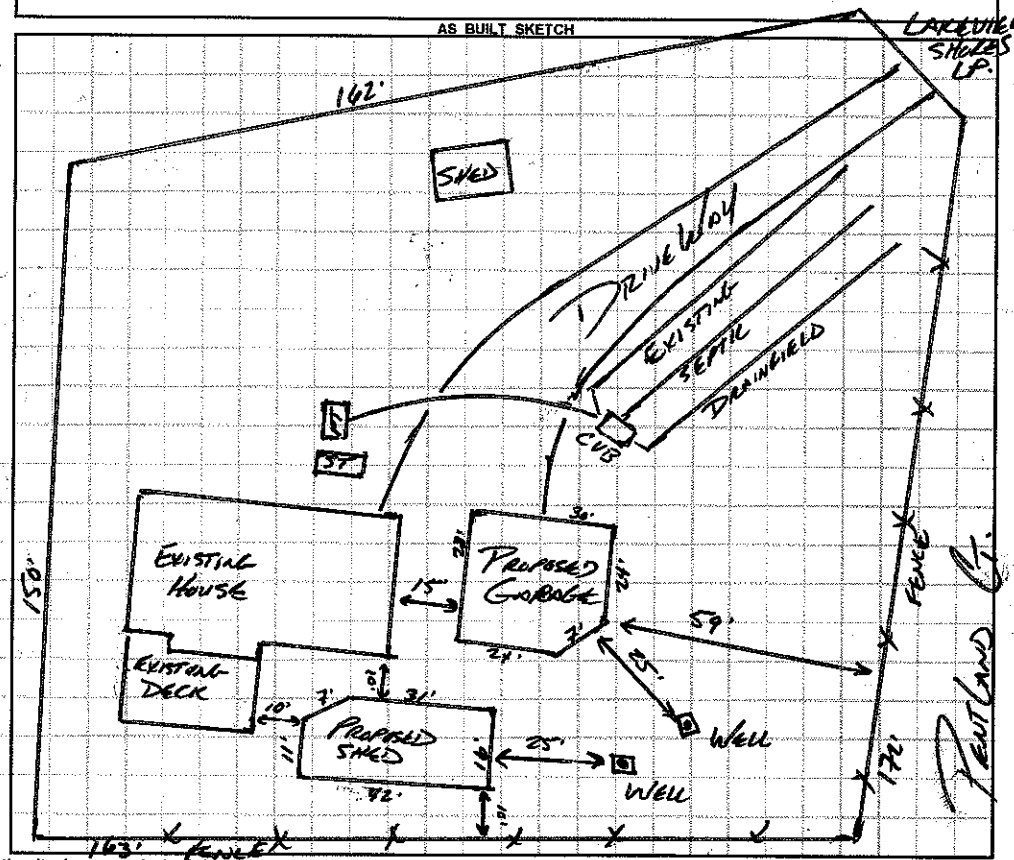

Permit can be suspended or revoked if any false information is supplied toward securing the permit / any unauthorized changes are made to the site / any unauthorized changes are made in the installation of the system. **CONTACT A LOCATOR SERVICE PRIOR TO ANY EXCAVATION**

☐ **IMPROVEMENT PERMIT** *with plat valid without expiration.* ☐ **IMPROVEMENT PERMIT** *with site plan valid for 60 mos.* ☐ **AUTHORIZATION TO CONSTRUCT** *valid for period equal to IMPROVEMENT PERMIT--not to exceed 60 mo.*

Owner / Applicant Signature: Raymond Workard Date: 2/17/16 Installed by:

IMPROVEMENT PERMIT by: Date: OPERATION PERMIT by: Date:

AUTHORIZATION TO CONSTRUCT by: Date: Existing System Inspected by:

APPROVED JAN 21 2016

Health Dept. Copy - WHITE Applicant (Final Approval) - YELLOW Applicant (Conditional Approval) - PINK