IREDELL COUNTY HEALTH DEPARTMENT

AUTHORIZATION TO CONSTRUCT

STATESVILLE 704-878-5305 MOORESVILLE 704-664-5281

IMPROVEMENT PERMIT / ~~CERTIFICATE OF COMPLETION~~ / OPERATION PERMIT / EXISTING SYSTEM INSPECTION

PROPERTY DESCRIPTION NO. 067093 DATE 5/19/97 TAX MAP NO. 4626193880 Watershed: ☑ Yes ☐ No

OWNER OR CONTRACTOR RALPH HINSON PHONE: Business Home 324-8095

ADDRESS PO BOX 967 CONOVER NC 28613

LOCATION BRAWLEY SCHOOL RD - JR MCKENDREE - TR LAKEVIEW - TL ABBOTT - TR LAKEVIEW - ON LEFT

SUBDIVISION LOT BLOCK / SECTION S LOT 269 LOT AREA SITE CLASS. PS DESIGN FLOW 360 GPD L.T.A.R. .3 GPD/FT

Septic Tank: 1000 Gallons; STB Date 7/14/98

Pump Tank: Gallons; PT Date

Pump Make: Model: Serial No.

Nitrification Field: No Fields 2 Square Feet 200 Linear Feet 100

No Lines 2@50' Trench Width 24" Max Trench Bottom Depth 36" Gravel Depth N/A

☑ New System ☐ Repair System Type: I, II, III, IV, V, VI

System Description: GRAVITY PANEL

Repair System Description: PUMP PANEL

Maintenance Agreement Required: ☐ Yes ☑ No

☑ House/Mod. Home No. Bedrooms 3

☐ Mobile Home No. Bathrooms 2

☐ Business No. Employees

☐ Other


☐ Slab ☑ Crawl Space ☐ Basement w/plumbing ☐ Basement wo/plumbing

Water Supply: ☑ Individual ☐ Community ☐ Public


Comments: 1"=40'

Comments: ABANDON OLD TANK - SET NEW TANK - ADD (2) 50' LINES.

INITIAL SITE SKETCH

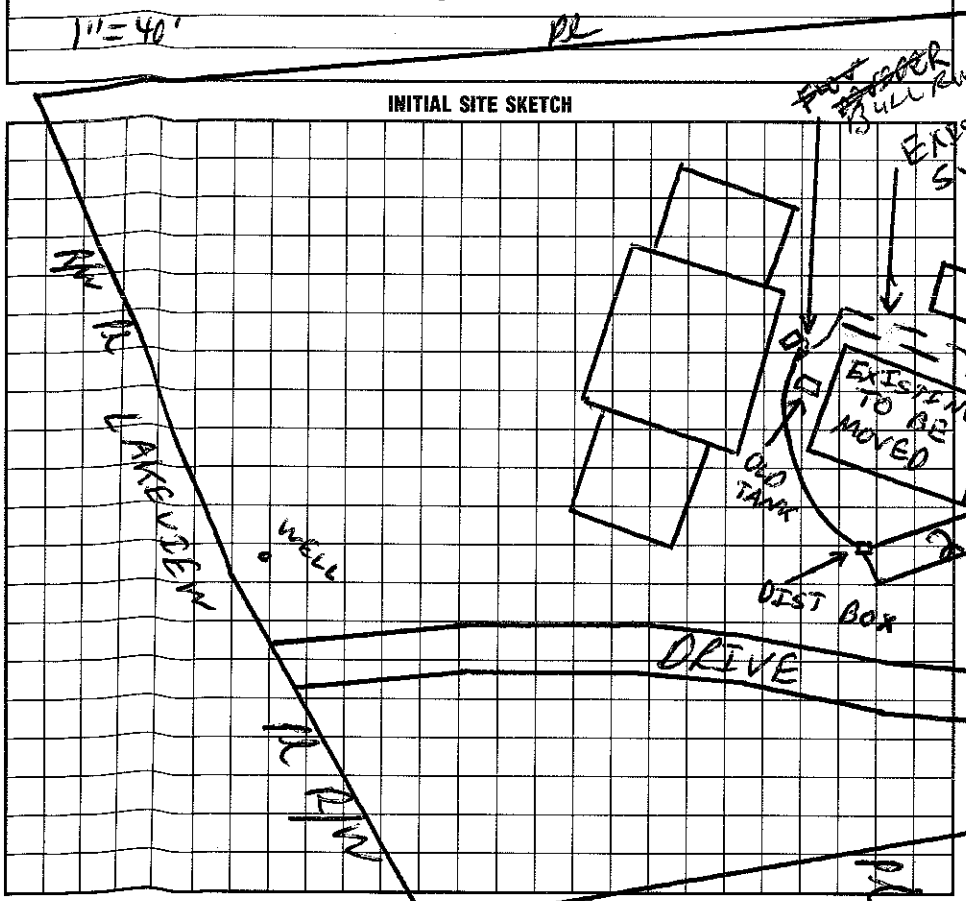

AS BUILT SKETCH

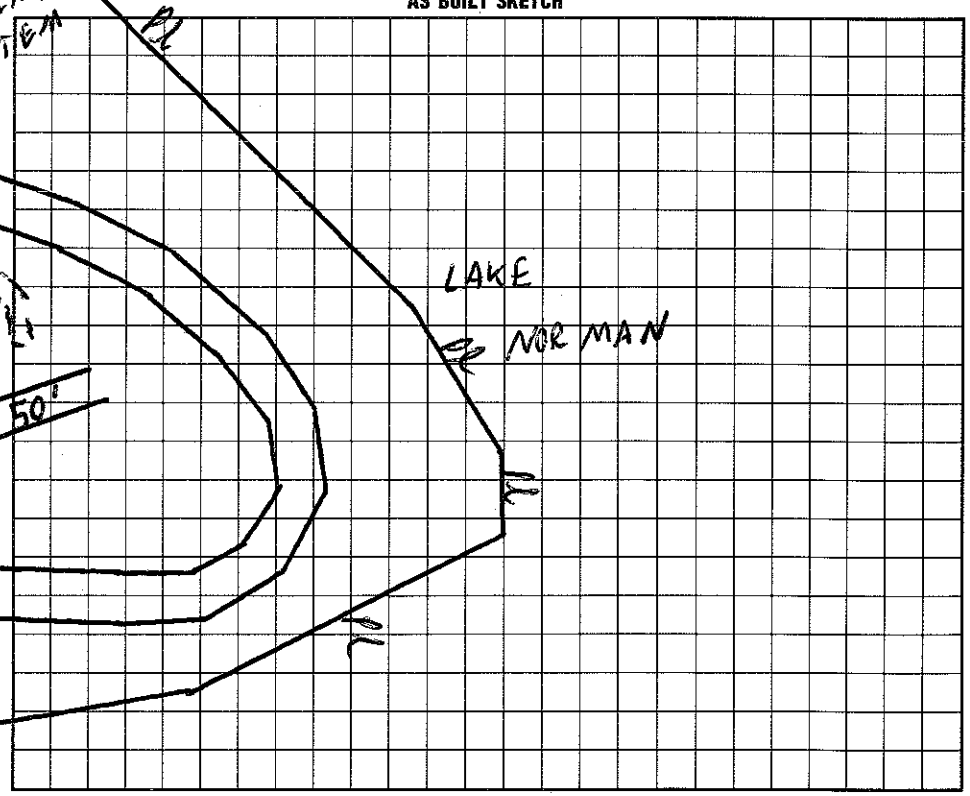

I understand that this permit can be suspended or revoked if any false information is supplied toward securing the permit/any unauthorized changes are made to the site/any unauthorized changes are made in the installation of the system. Improvement Permit is valid for 60 months from date of issuance.

Signed: FOR RALPH HINSON

Improvement Permit by: C. [signature] date 5/19/97

~~Existing System Inspection by:~~ AUTHORIZATION TO CONSTRUCT BY: C. [signature] date 5/19/97

Installed by: PJ ERVIN

Certificate of Completion by: date

Operation Permit by: C. [signature] date 9/29/98

HEALTH DEPT. COPY: WHITE INSPECTION COPY (FINAL): GREEN OWNER COPY (FINAL): YELLOW INSPECTION COPY (INITIAL): PINK OWNER COPY (INITIAL): GOLD