IREDELL COUNTY HEALTH DEPARTMENT - *ENVIRONMENTAL HEALTH* ☐ STATESVILLE OFFICE 704-878-5305 ☒ MOORESVILLE OFFICE 704-664-5281

IMPROVEMENT PERMIT / AUTHORIZATION TO CONSTRUCT / OPERATION PERMIT / EXISTING SYSTEM INSPECTION

PERMIT # ~~15329~~ 17314 PIN # 4626-19-8787 DATE 5-25-12

OWNER HARRIS CONSTRUCTION APPLICANT: ROBERT VALLES PHONE: Home/Cell # 704-202-3797 Business #

SITE ADDRESS 107 WILLOW BEND CT OWNER / APPLICANT ADDRESS 4436-D REA ROAD SUITE 210 CHARLOTTE NC

SITE DIRECTIONS BSR, MCRENDREE, LAKESHORE, ABBOT, WILLOW BEND

SUBDIVISION THE FARMS BLOCK / SECTION 4 LOT # 503 LOT AREA .994 AC DESIGN FLOW 480 L.T.A.R. .3

Septic Tank ~~1500~~ Gallons: STB 390 Date 9-27

Pump Tank Gallons: P T Date

Pump Make Model Serial #

No. Nitrification Fields: 1 No. Lines 5 Linear Feet 400'

Trench Width 36" Max. Trench Bottom Depth 36"

☒ ~~New System~~ ☐ Repair ☐ Expansion System Type I II (III) IV V VI

System Description: GRAVITY 25%

Repair System Description: LPP 30%

Maintenance Agreement Required ☐ YES ☒ ~~NO~~

Gravel Depth — ☒ GRAVITY ☐ PRESSURE

☒ ~~Residence~~ No. Bedrooms 4

☐ Business No. Persons

☐ Other No. Employees


☐ Slab ☒ Crawl Space

☐ Basement w/plumbing ☐ Basement w/o plumbing


Water Supply: ☐ Private ☐ Public ☒ ~~Community~~

Comments / Conditions

INITIAL SITE SKETCH

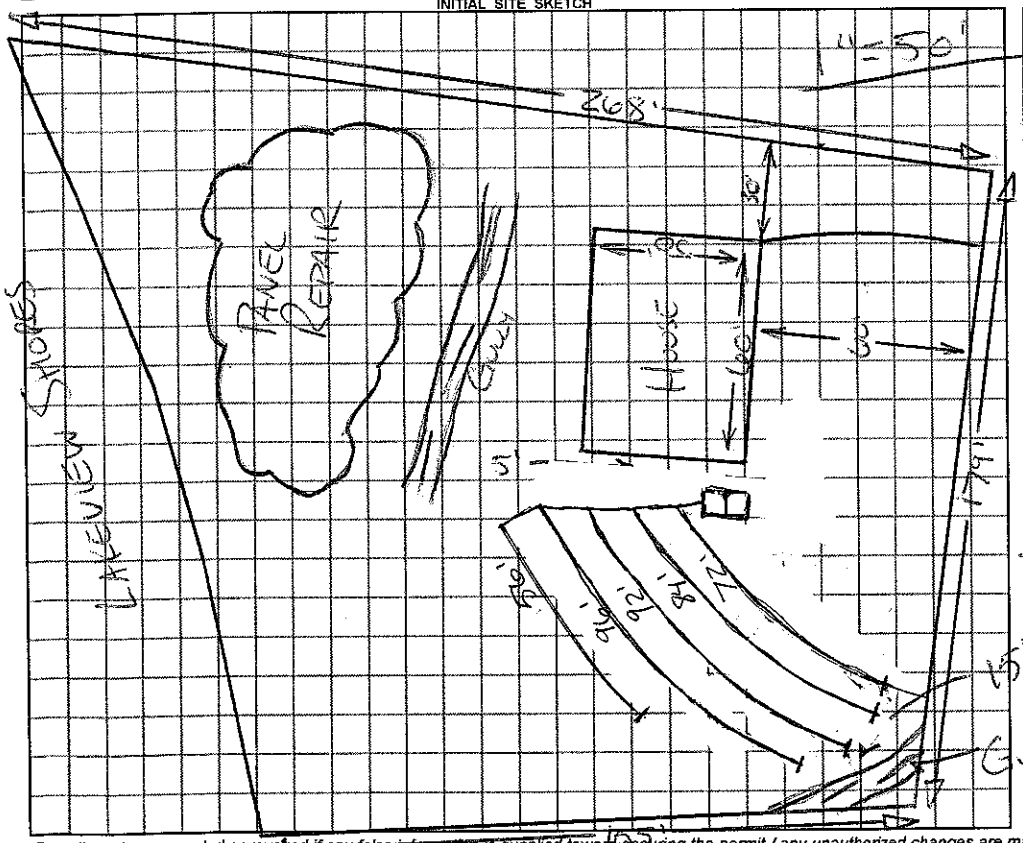

AS BUILT SKETCH

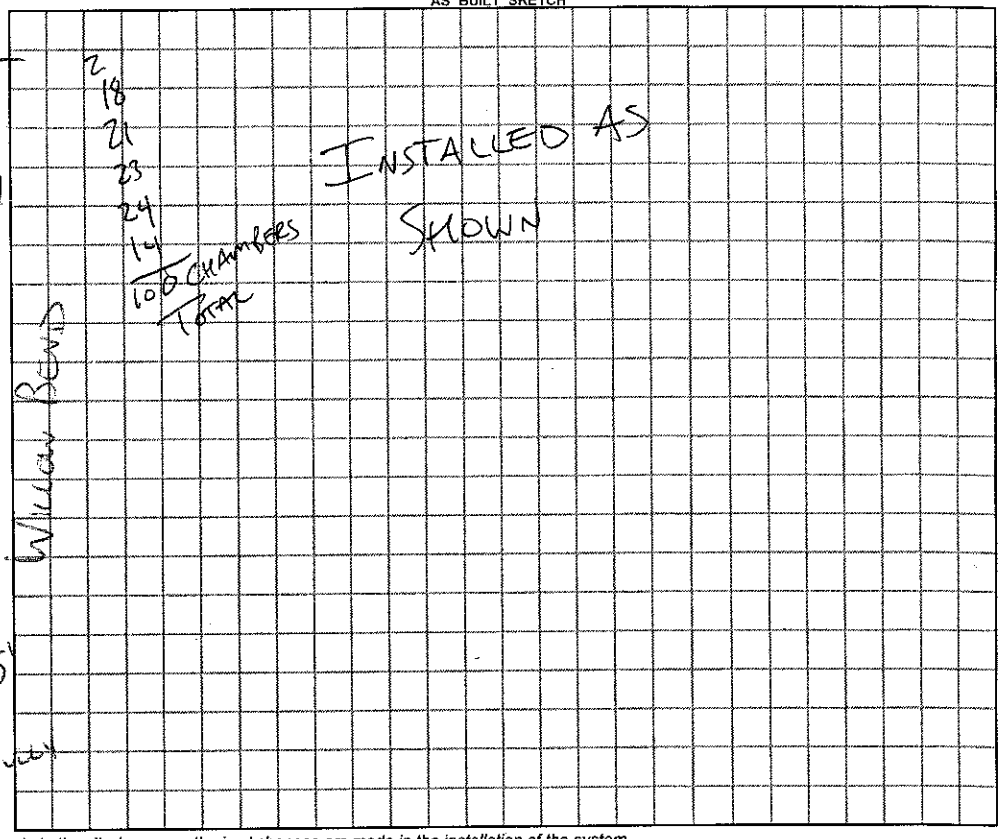

Permit can be suspended or revoked if any false information is supplied toward securing the permit / any unauthorized changes are made to the site / any unauthorized changes are made in the installation of the system.

☐ ***IMPROVEMENT PERMIT*** with plat valid without expiration. ☐ ***IMPROVEMENT PERMIT*** with ~~plat valid without expiration.~~ site plan valid 60 mo. ☐ ***AUTHORIZATION TO CONSTRUCT*** valid for period equal to IMPROVEMENT PERMIT--not to exceed 60 mo.

Owner / Applicant Signature: ABBOT Date

IMPROVEMENT PERMIT by: REHS Date 5-25-12

AUTHORIZATION TO CONSTRUCT by: REHS Date 6-12-12

Installed by: CHUB

OPERATION PERMIT by: REHS Date 9-28-12

Existing System Inspected by: REHS Date

YOU SHOULD CONTACT A LOCATOR SERVICE PRIOR TO ANY EXCAVATION

White Copy – Environmental Health YELLOW COPY (Final) Owner / Applicant PINK COPY (Initial) Owner / Applicant